

Well to be abandoned


Company Hope Natural Gas Co.
 Address Clarksburg, W. Va.
 Farm John Buck
 Tract Acres 150 Lease No. 2820
 Well (Farm) No. 1 Serial No. 349
 Elevation (Spirit Level) 756
 Quadrangle New Martinsville
 County Tyler District Lincoln
 Engineer S. H. Bradley
 Engineer's Registration No. 135
 File No. _____ Drawing No. _____
 Date 1-23-37 Scale 1" = 40 P

STATE OF WEST VIRGINIA
 Department of Mines
 OIL AND GAS DIVISION
 Charleston

WELL LOCATION MAP
 File No. TYL-127A

+ Denotes location of well on U. S. Topographic Maps, scale 1 to 62,500 latitude and longitude lines being represented by border lines as shown

— Denotes one inch spaces on border line of original tracing.

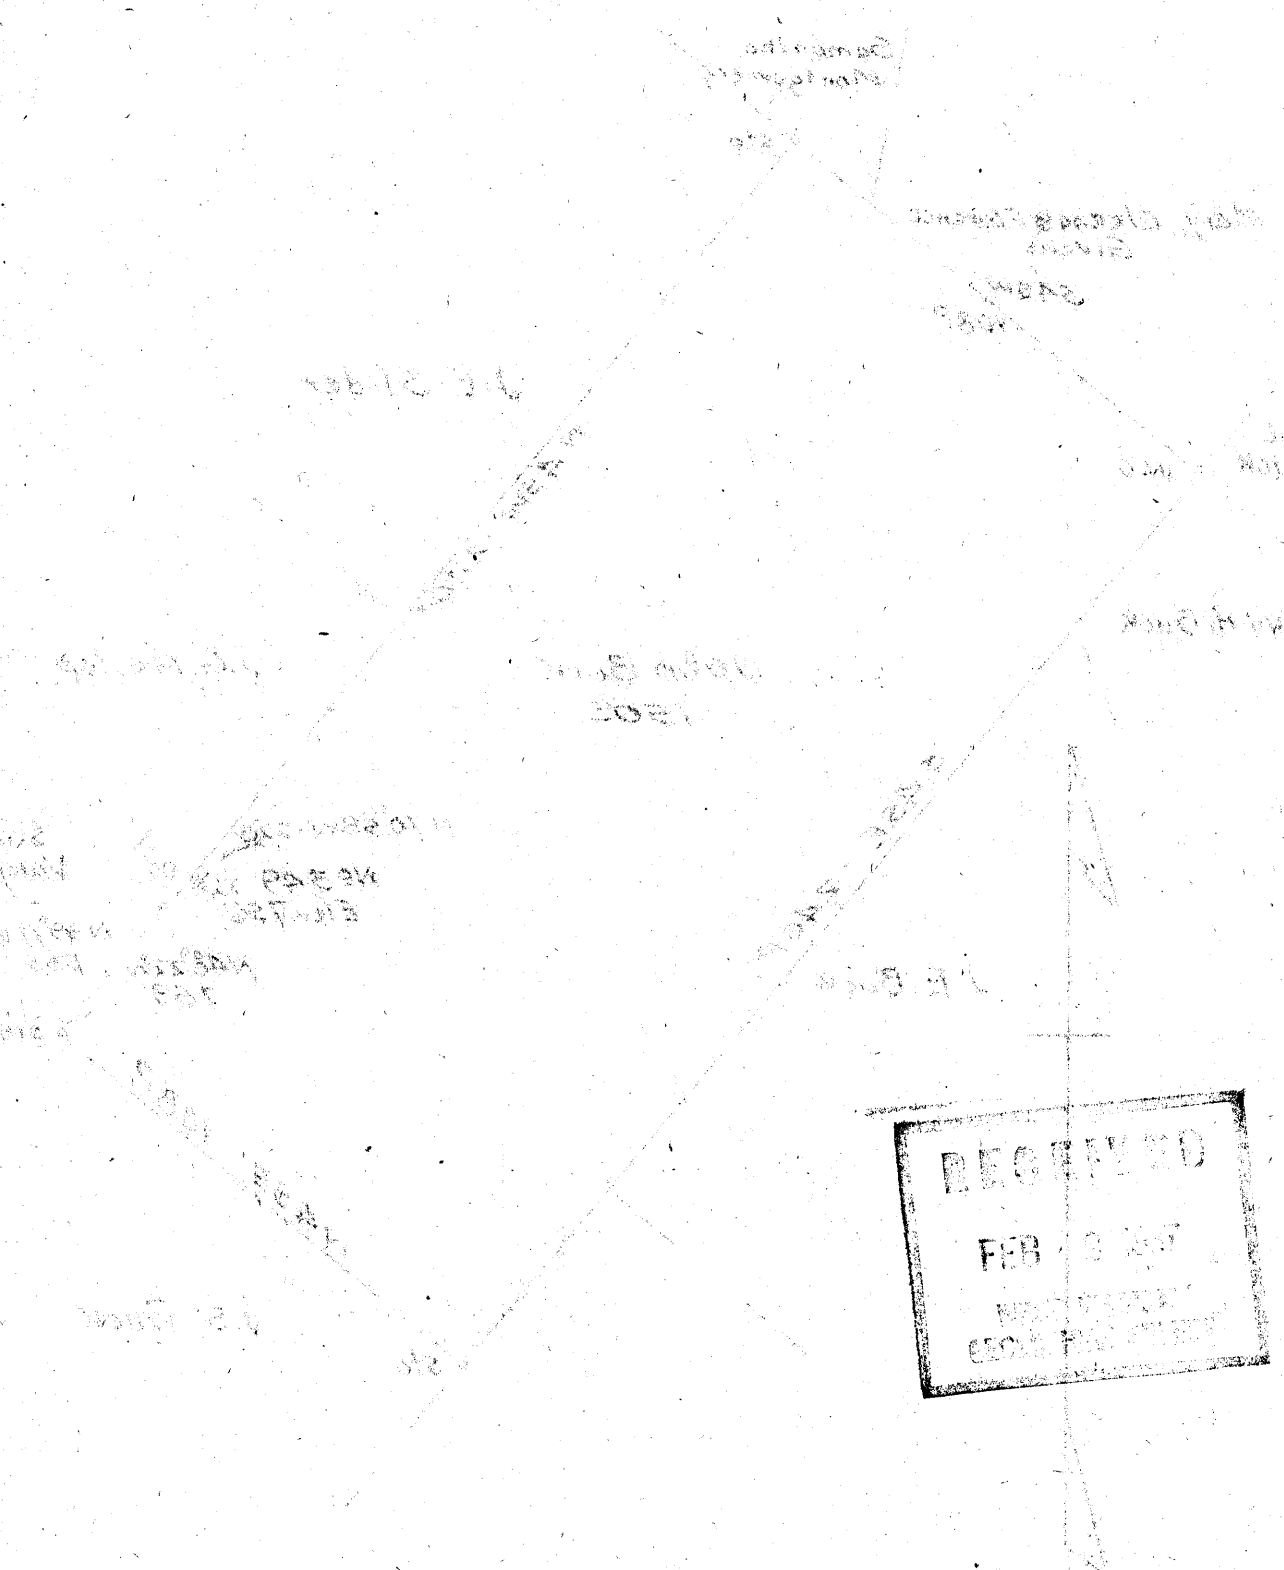

RECEIVED
 FEB 2 1957
 U.S. AIR FORCE
 ENGINEERING CENTER

SECRET

1. This drawing is a technical drawing of a diamond-shaped structure. It shows the overall dimensions and internal features. The drawing is oriented with its vertices at the top, bottom, left, and right. The labels 'TOP', 'BOTTOM', 'LEFT', and 'RIGHT' are placed along the edges. The drawing includes various lines, curves, and annotations. The dimensions are given in inches. The drawing is a technical drawing of a diamond-shaped structure. It shows the overall dimensions and internal features. The drawing is oriented with its vertices at the top, bottom, left, and right. The labels 'TOP', 'BOTTOM', 'LEFT', and 'RIGHT' are placed along the edges. The drawing includes various lines, curves, and annotations. The dimensions are given in inches. The drawing is a technical drawing of a diamond-shaped structure. It shows the overall dimensions and internal features. The drawing is oriented with its vertices at the top, bottom, left, and right. The labels 'TOP', 'BOTTOM', 'LEFT', and 'RIGHT' are placed along the edges. The drawing includes various lines, curves, and annotations. The dimensions are given in inches.

2. This drawing is a technical drawing of a diamond-shaped structure. It shows the overall dimensions and internal features. The drawing is oriented with its vertices at the top, bottom, left, and right. The labels 'TOP', 'BOTTOM', 'LEFT', and 'RIGHT' are placed along the edges. The drawing includes various lines, curves, and annotations. The dimensions are given in inches. The drawing is a technical drawing of a diamond-shaped structure. It shows the overall dimensions and internal features. The drawing is oriented with its vertices at the top, bottom, left, and right. The labels 'TOP', 'BOTTOM', 'LEFT', and 'RIGHT' are placed along the edges. The drawing includes various lines, curves, and annotations. The dimensions are given in inches. The drawing is a technical drawing of a diamond-shaped structure. It shows the overall dimensions and internal features. The drawing is oriented with its vertices at the top, bottom, left, and right. The labels 'TOP', 'BOTTOM', 'LEFT', and 'RIGHT' are placed along the edges. The drawing includes various lines, curves, and annotations. The dimensions are given in inches.