

Abandonment No. 2232 & 2231 - July 1937

Company	Hope Construction Refg. Co.
Address	Clarksburg, W.Va.
Farm	J.L.Poe
Tract	Acres 161 Lease No.
Well (Farm) No.	8 2232
Elevation (Spirit Level)	973
Quadrangle	West Union
County	Tyler District Meade
Engineer	John A. Clark
Engineer's Registration No.	744
File No.	Drawing No.
Date	7-13-1937 Scale 1"-40 Poles

STATE OF WEST VIRGINIA
 Department of Mines
 OIL AND GAS DIVISION
 CHARLESTON

WELL LOCATION MAP
 File No. TYL-137A

Denotes location of well on United States Topographic Maps, scale 1 to 62,500, latitude and longitude lines being represented by border lines as shown.

Denotes one inch spaces on border line of original tracing.

WEST VIRGINIA DEPARTMENT OF MINES
OIL AND GAS DIVISION

261

WELL RECORD

Permit No. ~~TL-138A~~ 138-A


Oil or Gas Well 011
(Kind)

Company Hope Construction & Refining Company
 Address Clarksburg, W. Va.,
 Farm J. L. Poe Acres 161
 Location (waters) McKim Creek
 Well No. 2231 Elev. 976
 District Meade County Tyler
 The surface of tract is owned in fee by _____
 Address _____
 Mineral rights are owned by _____
 Address _____
 Drilling commenced 3-17-1902
 Drilling completed 3-30-1902
 Date shot _____ Depth of shot _____
 Open Flow /10ths Water in _____ Inch
 /10ths Merc. in _____ Inch
 Volume _____ Cu. Ft.
 Rock Pressure _____ lbs. _____ hrs.
 Oil _____ bbls., 1st 24 hrs.
 Fresh water None recorded feet _____ feet
 Salt water None recorded feet _____ feet

Casing and Tubing	Used in Drilling	Left in Well	Packers
Size			Kind of Packer
16			
13			
10			Size of
8 1/4	495	495	
6 5/8 ^{6 1/4"}	1015	1015	Depth set
5 3/16			
3			Perf. top
2	1027	None	Perf. bottom
Liners Used			Perf. top
			Perf. bottom

CASING CEMENTED _____ SIZE _____ No. FT. _____ Date _____
Not cemented
 COAL WAS ENCOUNTERED AT _____ FEET _____ INCHES
No coal
 _____ FEET _____ INCHES _____ FEET _____ INCHES
 _____ FEET _____ INCHES _____ FEET _____ INCHES


Formation	Color	Hard or Soft	Top	Bottom	Oil Gas or Water	Depth Found	Remarks
Red Rock Cave			900	1000			
First Cow Run Sand			1015	1036	1015		
			Total Depth	1037			

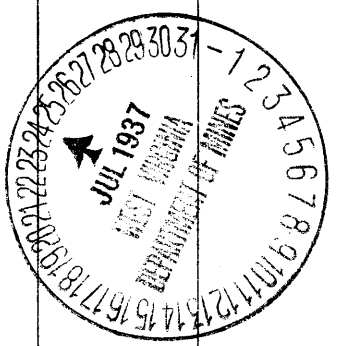

Formation	Color	Hard or Soft	Top	Bottom	Oil, Gas or Water	Depth Found	Remarks

Date July 23, 19 37

APPROVED Hope Construction & Refining Co., Owner

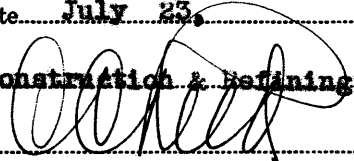By 
 (Title) Asst. General Supt.,

Meade District, Tyler County, W. Va. 128A

By Hope Construction & Refining Co., Clarksburg, W. Va.

On 161 acres, on McKim Creek.

Elevation, 976' L.

Drilling commenced 3-17-1902; completed, 3-30-1902.

No water recorded.

8 $\frac{1}{4}$ " casing, 495'; 6 $\frac{1}{4}$ " , 1015'; 2" tubing, 1027' (pulled).

Casing not cemented. No coal was encountered.

Oil well. Abandonment reported to Dept. of Mines July 23, 1937.

Record to RCT from D. G. Courtney 2-1-38.

	Top.	Bottom.
Red rock cave	900	1000
First Cow Run Sand (oil, 1015')	1015	1036
Total depth		1037