


LATITUDE 39° 20'

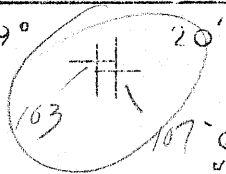

LONGITUDE 80° 50'

B. F. Montgomery


I. D. Smith

Jas. Dotson

Jno. Exlin

Cisco Dotson

N. Miller

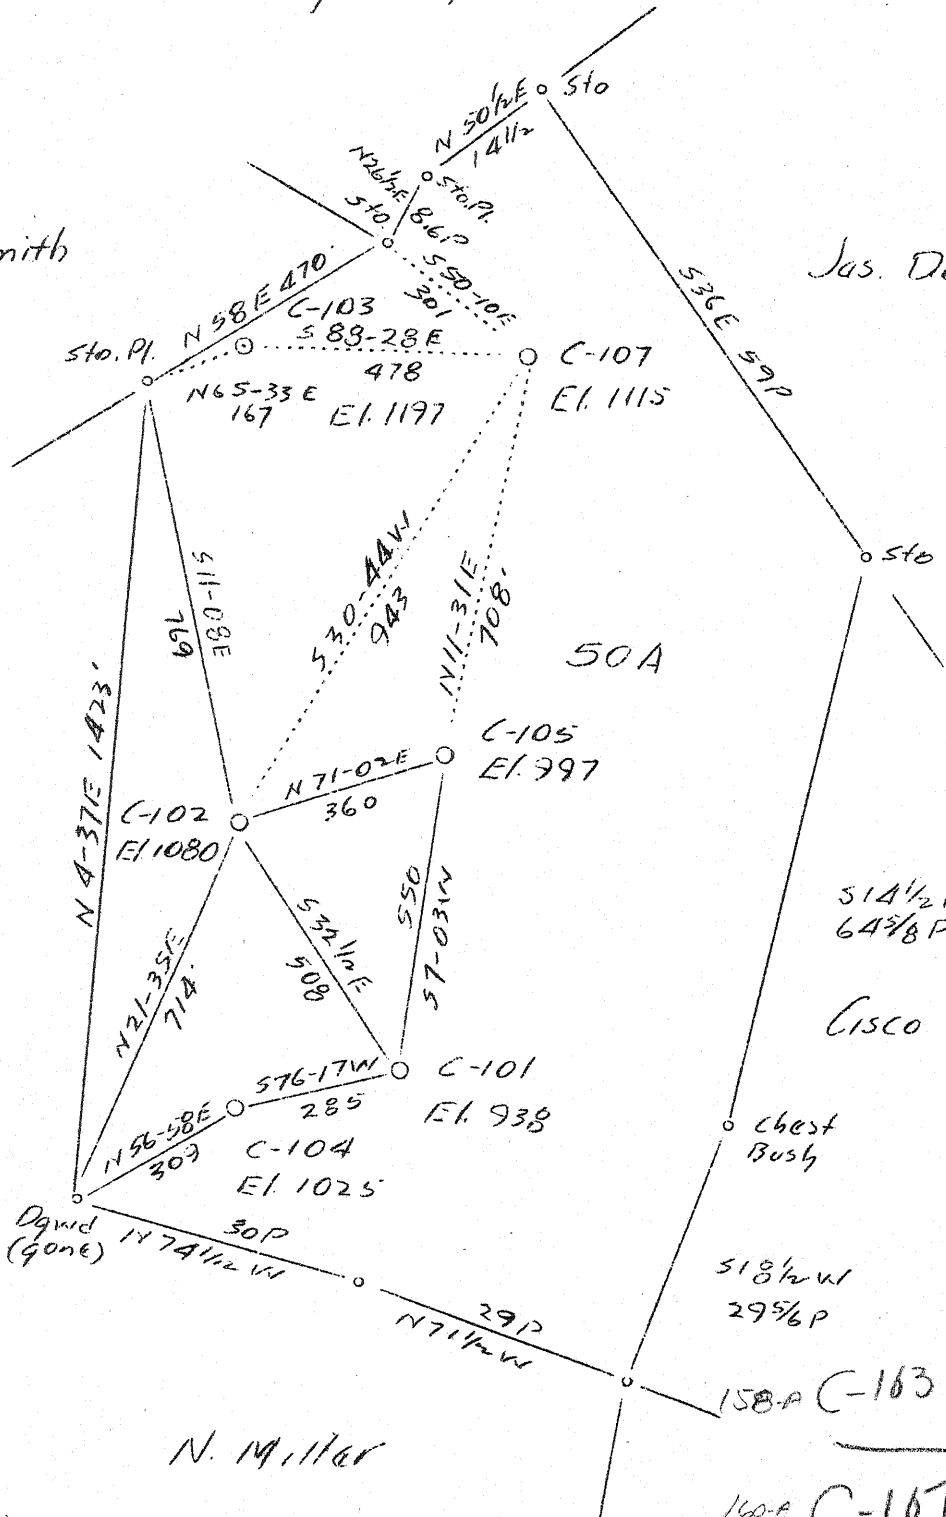

Abel C-103 & C-107

F.B. 655 P. 22-23 54 60 58 W 113

Company	Hope Const'r. & Ref. Co.
Address	Clarksburg, W.Va.
Farm	E.M. Jackson
Tract	1 Acres 50
Lease No.	3841
Well (Farm) No.	3 & 7
Serial No.	C-101-102 103-104 105-107
Elevation (Spirit Level)	938-1080-1197-1025
Quadrangle	West Union 997-1115
County	Tyler
District	Centerville
Engineer	W.M. Bowers
Engineer's Registration No.	900
File No.	
Drawing No.	
Date	Feb. 3, 1938
Scale	1"-20 P.

STATE OF WEST VIRGINIA  
 Department of Mines  
 OIL AND GAS DIVISION  
 CHARLESTON

WELL LOCATION MAP  
 File No. TYL-158A+160

+ Denotes location of well on United States Topographic Maps, scale 1 to 62,500, latitude and longitude lines being represented by border lines as shown.

— Denotes one inch spaces on border line of original tracing.

Rec'd WVGS Feb 15, 1938