


LATITUDE 39° 35'

LONGITUDE 80° 00'

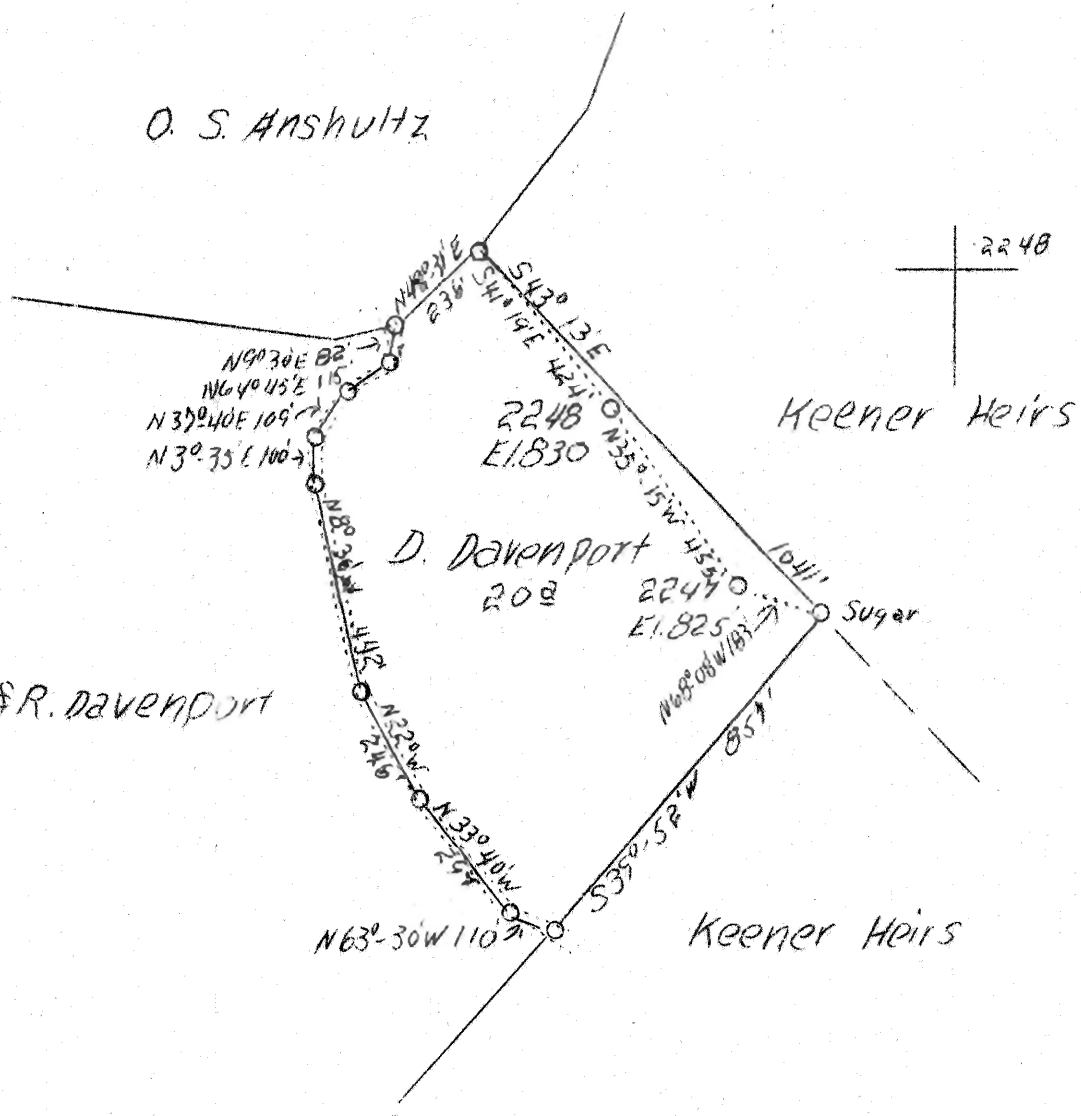

1,83 W
 3.61 3.65

ABD.

JUN 21 1938

SE

Company Hope Const. & Refining Co.
 Address Clarksburg, W. Va.
 Farm D. Davenport
 Acres 20
 Lease No. 6137
 Serial No. 2247-2248
 Elevation 825-830 (Spirit Level)
 Quadrangle New Matamoras
 County Tyler
 District Union
 Engineer W. M. Bowers
 Eng. Reg. No. 900
 Date June 9, 1938
 Scale 1" = 400'

STATE OF WEST VIRGINIA
 Department of Mines
 OIL & GAS DIVISION
 Charleston

WELL LOCATION MAP
 File No. TYL-173-A

X Denotes location of well on U. S. Topographic Maps, scale 1 to 62,500, latitude and longitude lines being represented by border lines as shown.

- Denotes one inch spaces on border line of original tracing.

WEST VIRGINIA DEPARTMENT OF MINES
OIL AND GAS DIVISION

WELL RECORD

270

Permit No.

Oil or Gas Well Oil
(Kind)

Company Hope Construction & Refining Company
 Address Clarksburg, w. Va.,
 Farm D. Davenport Acres 20
 Location (waters) Ohio River
 Well No. 2248 Elev. 830
 District Union County Tyler
 The surface of tract is owned in fee by.....
 Address.....
 Mineral rights are owned by.....
 Address.....
 Drilling commenced 4-25-1895
 Drilling completed 5-12-1895
 Date shot 7-9-1924 Depth of shot Injun
 Open Flow /10ths Water in..... Inch
 /10ths Merc. in..... Inch
 Volume..... Cu. Ft.
 Rock Pressure..... lbs..... hrs.
 Oil..... bbls., 1st 24 hrs.
 Fresh water None recorded feet..... feet
 Salt water None recorded feet..... feet

Casing and Tubing	Used in Drilling	Left in Well	Packers
Size			
16.....			Kind of Packer.....
13.....	140	Pulled	
10.....			Size of.....
8 1/4.....	790	Pulled	
6 5/8 6 1/2.....	1250	1250	Depth set.....
5 3/16.....			
3.....			Perf. top.....
2.....	1694	1694	Perf. bottom.....
Liners Used.....			Perf. top.....
			Perf. bottom.....

CASING CEMENTED..... SIZE..... No. FT..... Date
Not cemented
 COAL WAS ENCOUNTERED AT -360 FEET ? INCHES
calculated
 FEET..... INCHES..... FEET..... INCHES
 FEET..... INCHES..... FEET..... INCHES

Formation	Color	Hard or Soft	Top	Bottom	Oil Gas or Water	Depth Found	Remarks
Pittsburgh Coal		(Calculated)	360	365			
Cow Run Sand			810	830			
Salt Sand			1000	1250			
Big Lime			1498	1550			
Big Injun Sand			1597	1701	Oil	1597-1632	
Total Depth-----			1704				



Formation	Color	Hard or Soft	Top	Bottom	Oil, Gas or Water	Depth Found	Remarks

Date June 8, 1938

APPROVED Hope Construction & Refining Co., Owner

By [Signature] Asst. General Supt.
(Title) mn