


LATITUDE 39° 35'

LONGITUDE 81° 00'

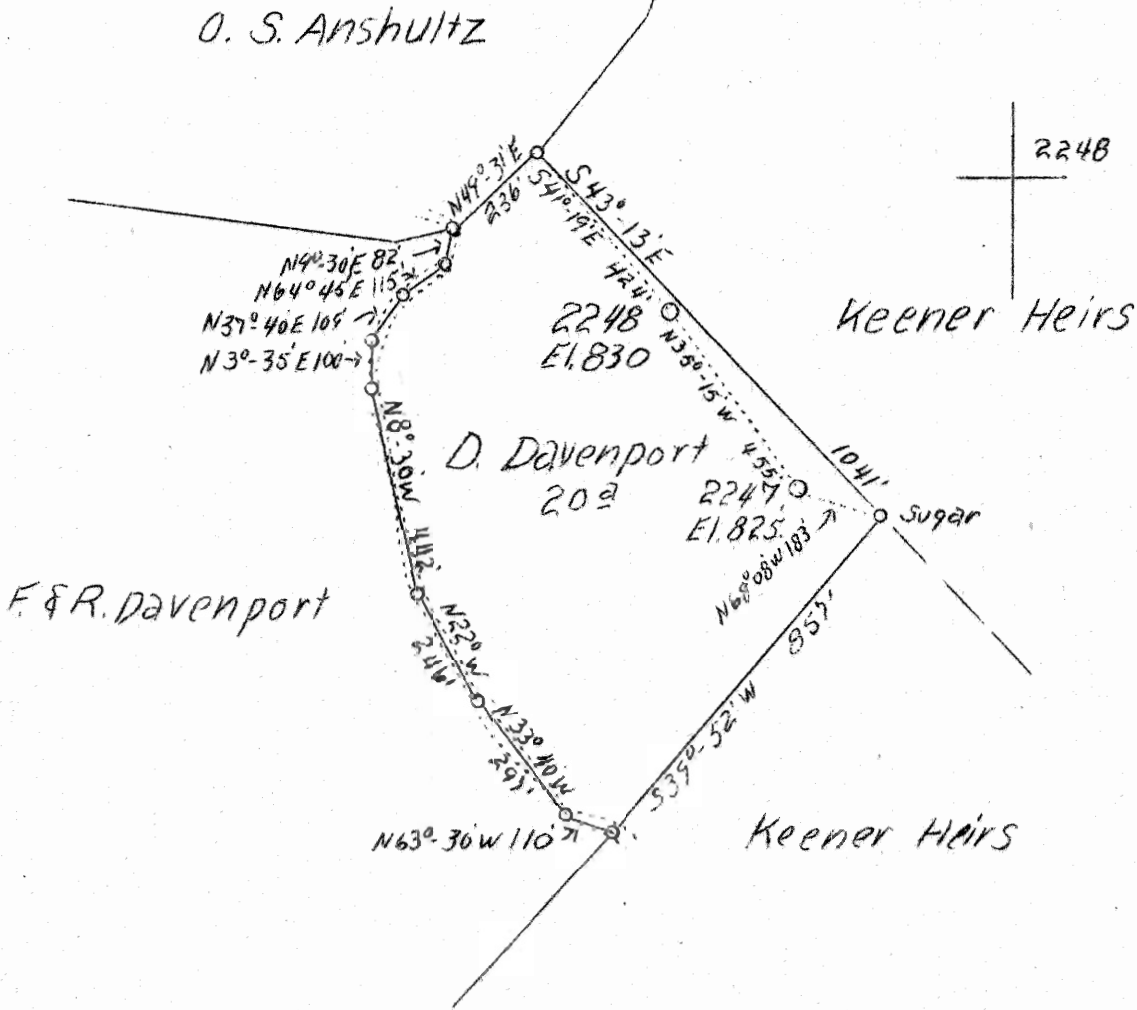

ABD. 2248 (2247) JUL 26 1938

1.80 W  
3.61 3.66

SE

Company	Hope Constr. & Ref. Co.,
Address	Clarksburg, W. Va.
Farm	D. Davenport
Acres	20
Lease No.	6137
Well (Farm) No.	2247
Serial No.	2247-2248
Elevation (S.P.)	825-830
Quadrangle	New Matamoras
County	Tyler
District	Union
Engineer	W. M. Bowers
Eng. Reg. No.	900
Date	June 9, 1938
Scale	1" = 400'

STATE OF WEST VIRGINIA  
 Department of Mines  
 OIL & GAS DIVISION  
 Charleston

WELL LOCATION MAP  
 File No. TYL-177-A

X Denotes location of well on U. S. Topographic Maps, scale 1 to 62,500, latitude and longitude lines being represented by border lines as shown.

- Denotes one inch spaces on border line of original tracing.

WEST VIRGINIA DEPARTMENT OF MINES  
OIL AND GAS DIVISION

WELL RECORD

769

Permit No. ....

Oil or Gas Well Oil  
(Kind)

Company Hope Construction & Refining Company  
Address Clarksburg, w. Va.  
Farm D. Davenport Acres 20  
Location (waters) Ohio River  
Well No. 2247 Elev. 825  
District Union County Tyler  
The surface of tract is owned in fee by .....  
Address .....  
Mineral rights are owned by .....  
Address .....  
Drilling commenced 1893  
Drilling completed 10-29-1893  
Date shot No record Depth of shot .....  
Open Flow /10ths Water in ..... Inch  
/10ths Merc. in ..... Inch  
Volume ..... Cu. Ft.  
Rock Pressure ..... lbs. .... hrs.  
Oil ..... bbls., 1st 24 hrs.  
Fresh water No record feet ..... feet  
Salt water No record feet ..... feet

Casing and Tubing	Used in Drilling	Left in Well	Packers
Size			
16			Kind of Packer
13			
10	150	130	Size of
8 1/2	720	Pulled	
<del>6 5/8</del> <u>6 1/4</u>	1195	1195	Depth set
<del>5 3/16</del> <u>5 7/8</u>	814	814	
3			Perf. top
2	1628	1628	Perf. bottom
Liners Used			Perf. top
			Perf. bottom

CASING CEMENTED ..... SIZE ..... No. FT. .... Date  
Not cemented  
COAL WAS ENCOUNTERED AT 555 FEET 60 INCHES  
Calculated  
FEET ..... INCHES ..... FEET ..... INCHES  
FEET ..... INCHES ..... FEET ..... INCHES

Formation	Color	Hard or Soft	Top	Bottom	Oil Gas or Water	Depth Found	Remarks
Pittsburgh coal		(Calculated)	355	360			
Cow Run Sand		(Calculated)	805	825			
salt sand		(Calculated)	995	1245			
Big Lime		(Calculated)	1495	1545			
Big Injun Sand		(Calculated)	1592		Oil	1592-1628	(Calculated)
		Total Depth		1644			



