

Ad b.

|                 |                   |
|-----------------|-------------------|
| Company         | McIntyre & Wright |
| Address         | Alvy              |
| Farm            | A. G. Bridgeman   |
| Tract           | One               |
| Acres           | 117               |
| Well (Farm) No. | Two               |
| Elevation (SP)  | 1097'             |
| Quadrangle      | New Martinsville  |
| County          | Tyler             |
| District        | Ellsworth         |
| Engineer        | J. S. Haught      |
| Eng. Reg. No.   | C.S.T. Co.        |
| Date            | August 29, 1938   |
| Scale           | 1" = 40 rods.     |


STATE OF WEST VIRGINIA  
 Department of Mines  
 OIL & GAS DIVISION  
 Charleston

WELL LOCATION MAP

File No. TYL-183A

x Denotes location of well on U. S. Topographic Maps, scale 1 to 62,500, latitude and longitude lines being represented by border lines as shown.

- Denotes one inch spaces on border line of original tracing.

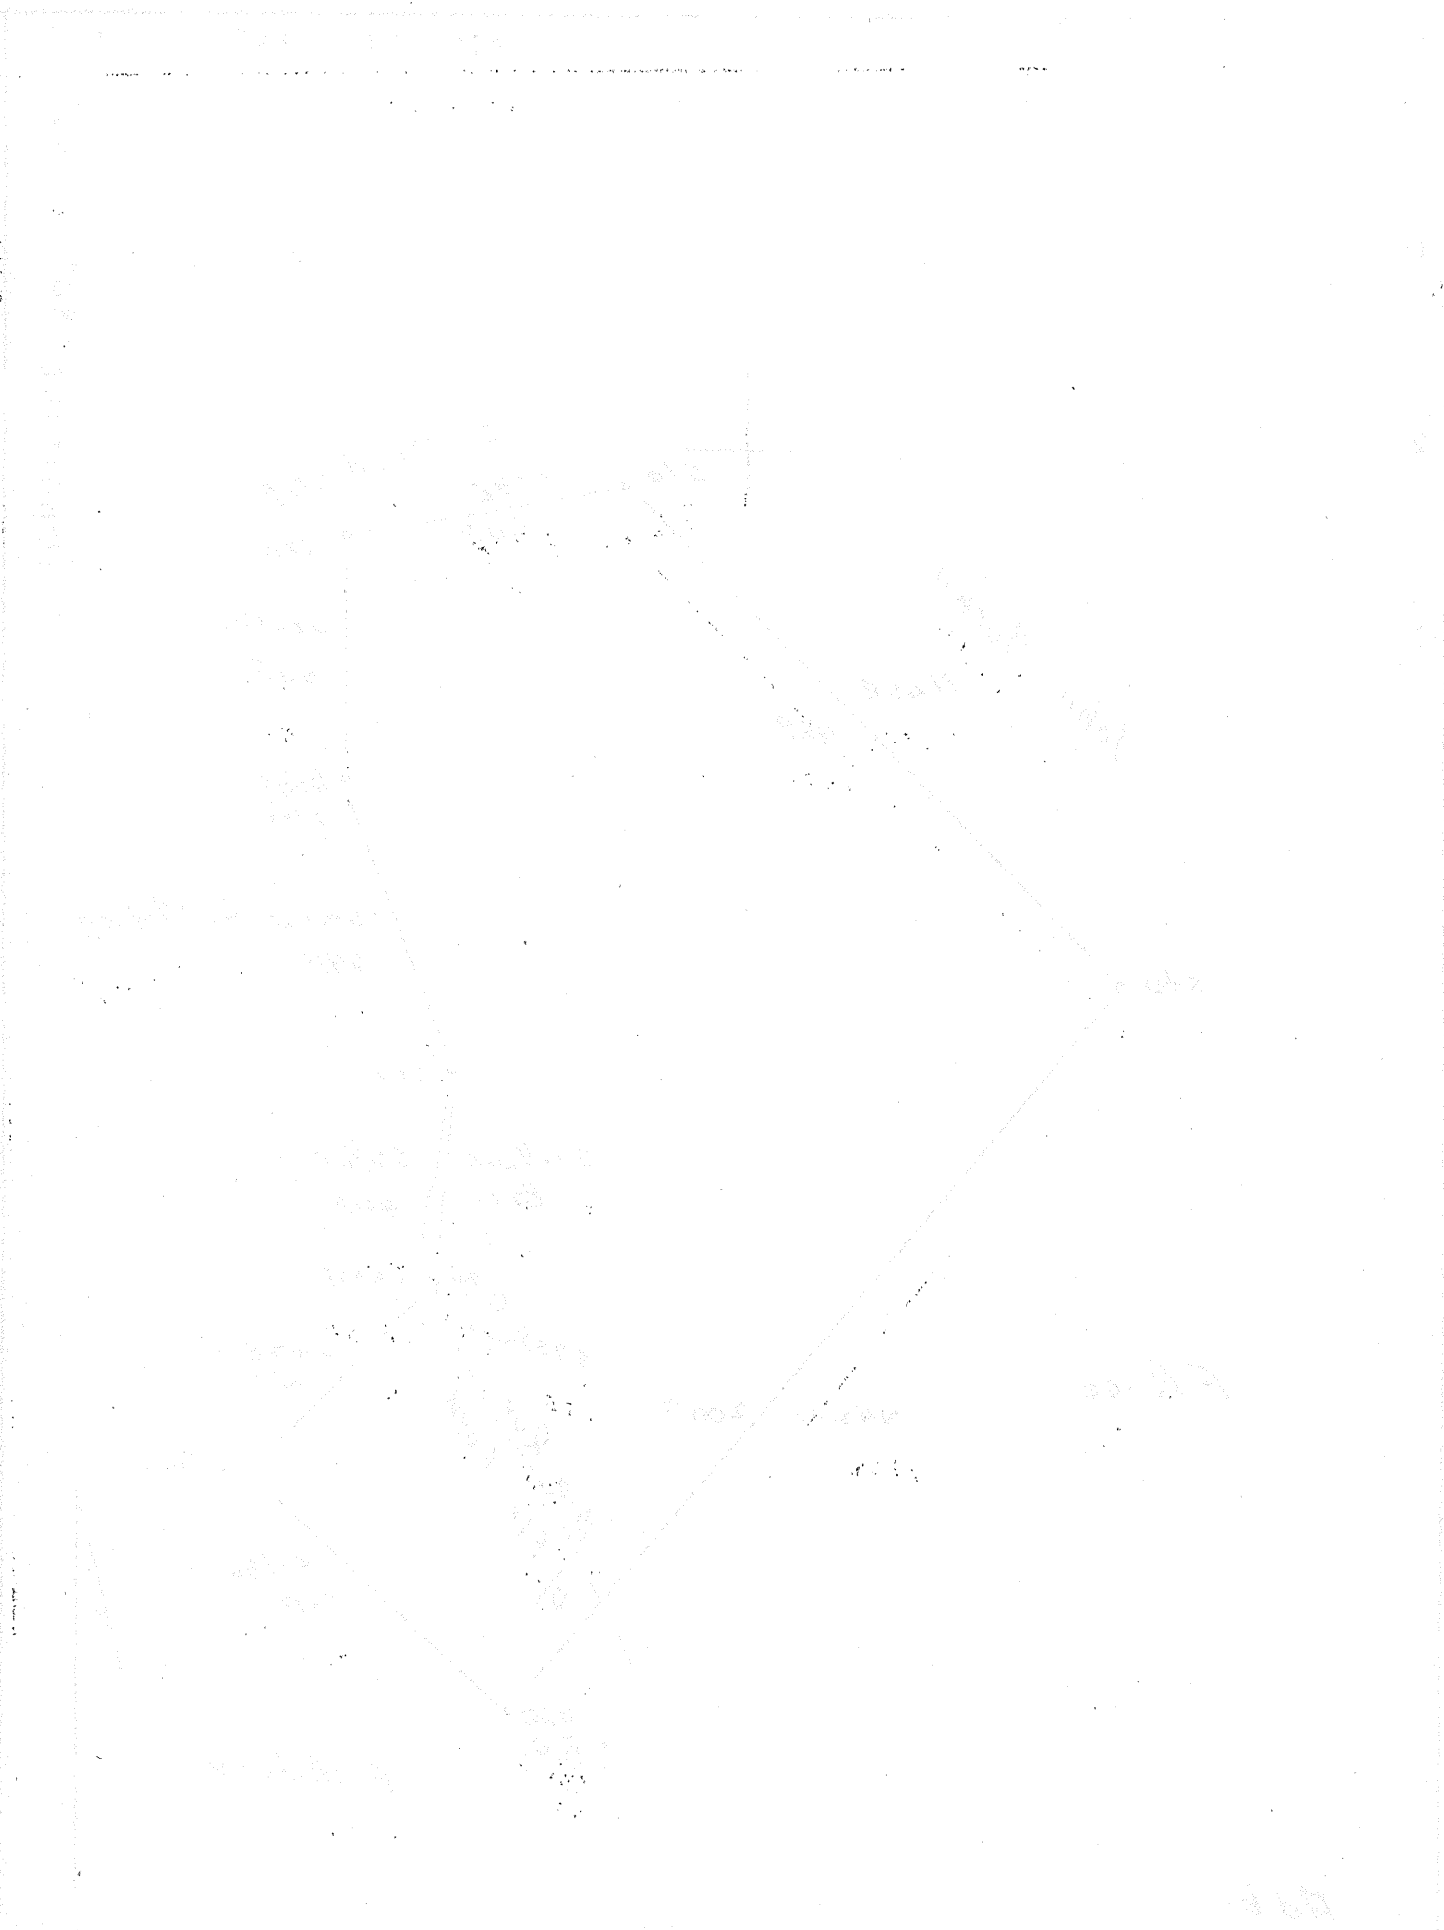

100  
 200  
 300  
 400

RECEIVED  
 JUN 1 1970  
 U.S. AIR FORCE  
 WASHINGTON, D.C.