

LATITUDE 39° 35'

LONGITUDE 80° 53'

80 57 30

1.645  
330W



J. L. Thistle

Sam Cox

2051  
El. 1049


Nat Salisbury

1.645  
106W

C. KNOCKE  
49 28 3  
100

Surface Owners  
Mrs. O. M. Barrett  
H. B. Woodburn

R. S. McCormick

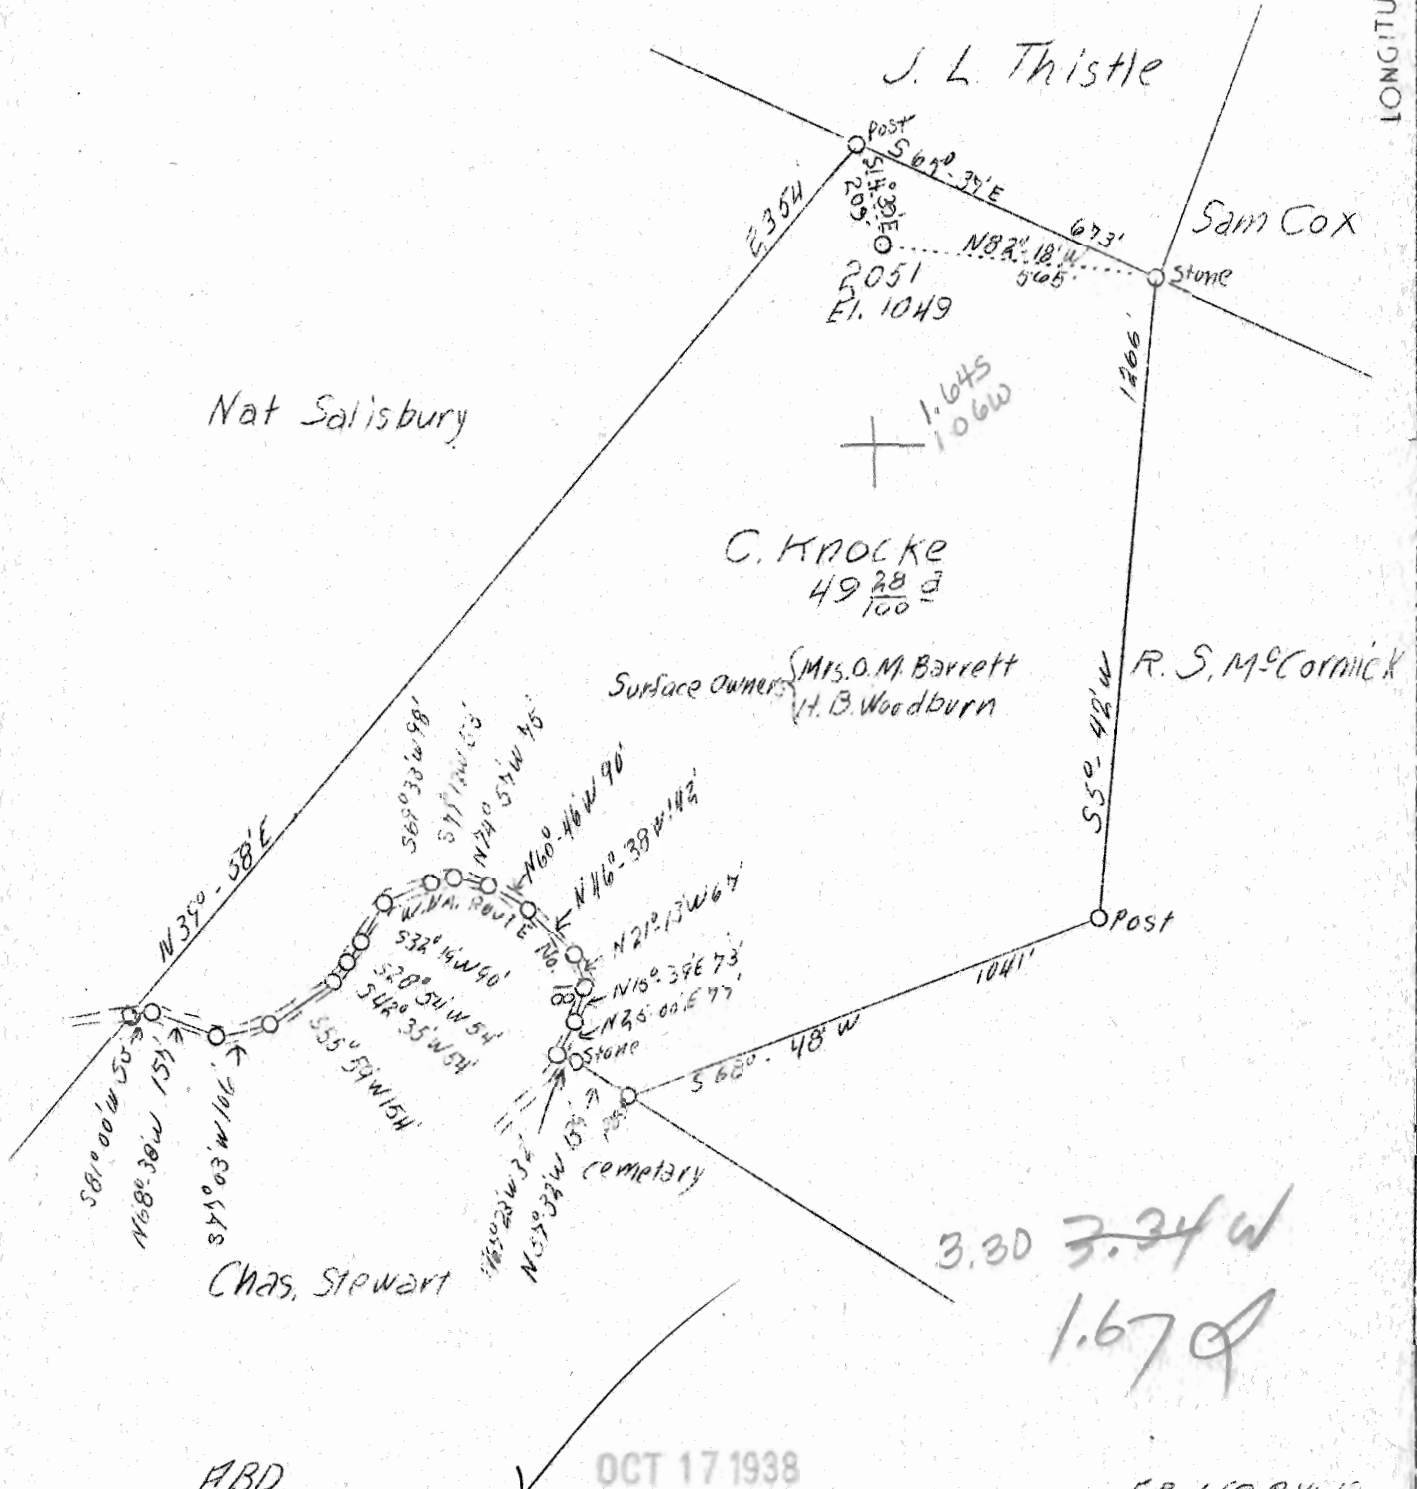

ABD.

OCT 17 1938

FB. 659 P10-12

Company	Hope Constr. & Ref. Co.
Address	Clarksburg, W. Va.
Farm	C. Knocke
Acres	49-28/100
Lease No.	6065
Well (Farm) No.	-
Serial No.	2051
Elevation (SP)	1049
Quadrangle	New Martinsville
County	Tyler
District	Lincoln
Engineer	W. M. Bowers
Eng. Reg. No.	900
Date	10-7-38
Scale	1" - 400'

(SW)

STATE OF WEST VIRGINIA  
 Department of Mines  
 OIL & GAS DIVISION  
 Charleston

WELL LOCATION MAP

File No. TYL-186-A

x Denotes location of well on U. S. Topographic Maps, scale 1 to 62,500, latitude and longitude lines being represented by border lines as shown.

- Denotes one inch spaces on border line of original tracing.

WEST VIRGINIA DEPARTMENT OF MINES  
OIL AND GAS DIVISION

277

WELL RECORD

Permit No. 186A

Oil or Gas Well Oil  
(Kind)

Company Hope Construction & Refining Company;  
Address Clarksburg, W. Va.  
Farm C. Knocke Acres 49.28  
Location (waters).....  
Well No. 2051 Elev. 1049  
District Lincoln County Tyler  
The surface of tract is owned in fee by H. B. Woodburn  
Address Sistersville, W. Va.  
Mineral rights are owned by.....  
Address.....  
Drilling commenced 8-15-1893  
Drilling completed 10-5-1893  
Date shot No record Depth of shot.....  
Open Flow /10ths Water in.....Inch  
/10ths Merc. in.....Inch  
Volume.....Cu. Ft.  
Rock Pressure.....lbs.....hrs.  
Oil.....bbls., 1st 24 hrs.  
Fresh water None recorded feet.....feet  
Salt water None recorded feet.....feet

Casing and Tubing	Used in Drilling	Left in Well	Packers
Size			
16.....			Kind of Packer.....
13.....			
10.....	<u>995</u>	<u>995</u>	Size of.....
8 1/4.....	<u>995</u>	<u>995</u>	
6 5/8 <u>6 1/2"</u>	<u>1260</u>	<u>1260</u>	Depth set.....
5 3/16 <u>4-7/8"</u>	<u>1290</u>	<u>1290</u>	
3.....			Perf. top.....
2.....	<u>1891</u>	<u>1891</u>	Perf. bottom.....
Liners Used.....			Perf. top.....
			Perf. bottom.....

CASING CEMENTED.....SIZE.....No. FT.....Date  
Not cemented  
COAL WAS ENCOUNTERED AT.....FEET.....INCHES  
FEET None recorded FEET.....INCHES  
FEET.....INCHES.....FEET.....INCHES

Formation	Color	Hard or Soft	Top	Bottom	Oil Gas or Water	Depth Found	Remarks
Coal		(Calculated)	480	485			
First Salt Sand			1300	No record			
Big Lime			1740	1830			
Big Injun Sand			1840		Oil	1850 1870	
Total Depth			-----				1901

