


LATITUDE 39° 35'

LONGITUDE 80° 55'

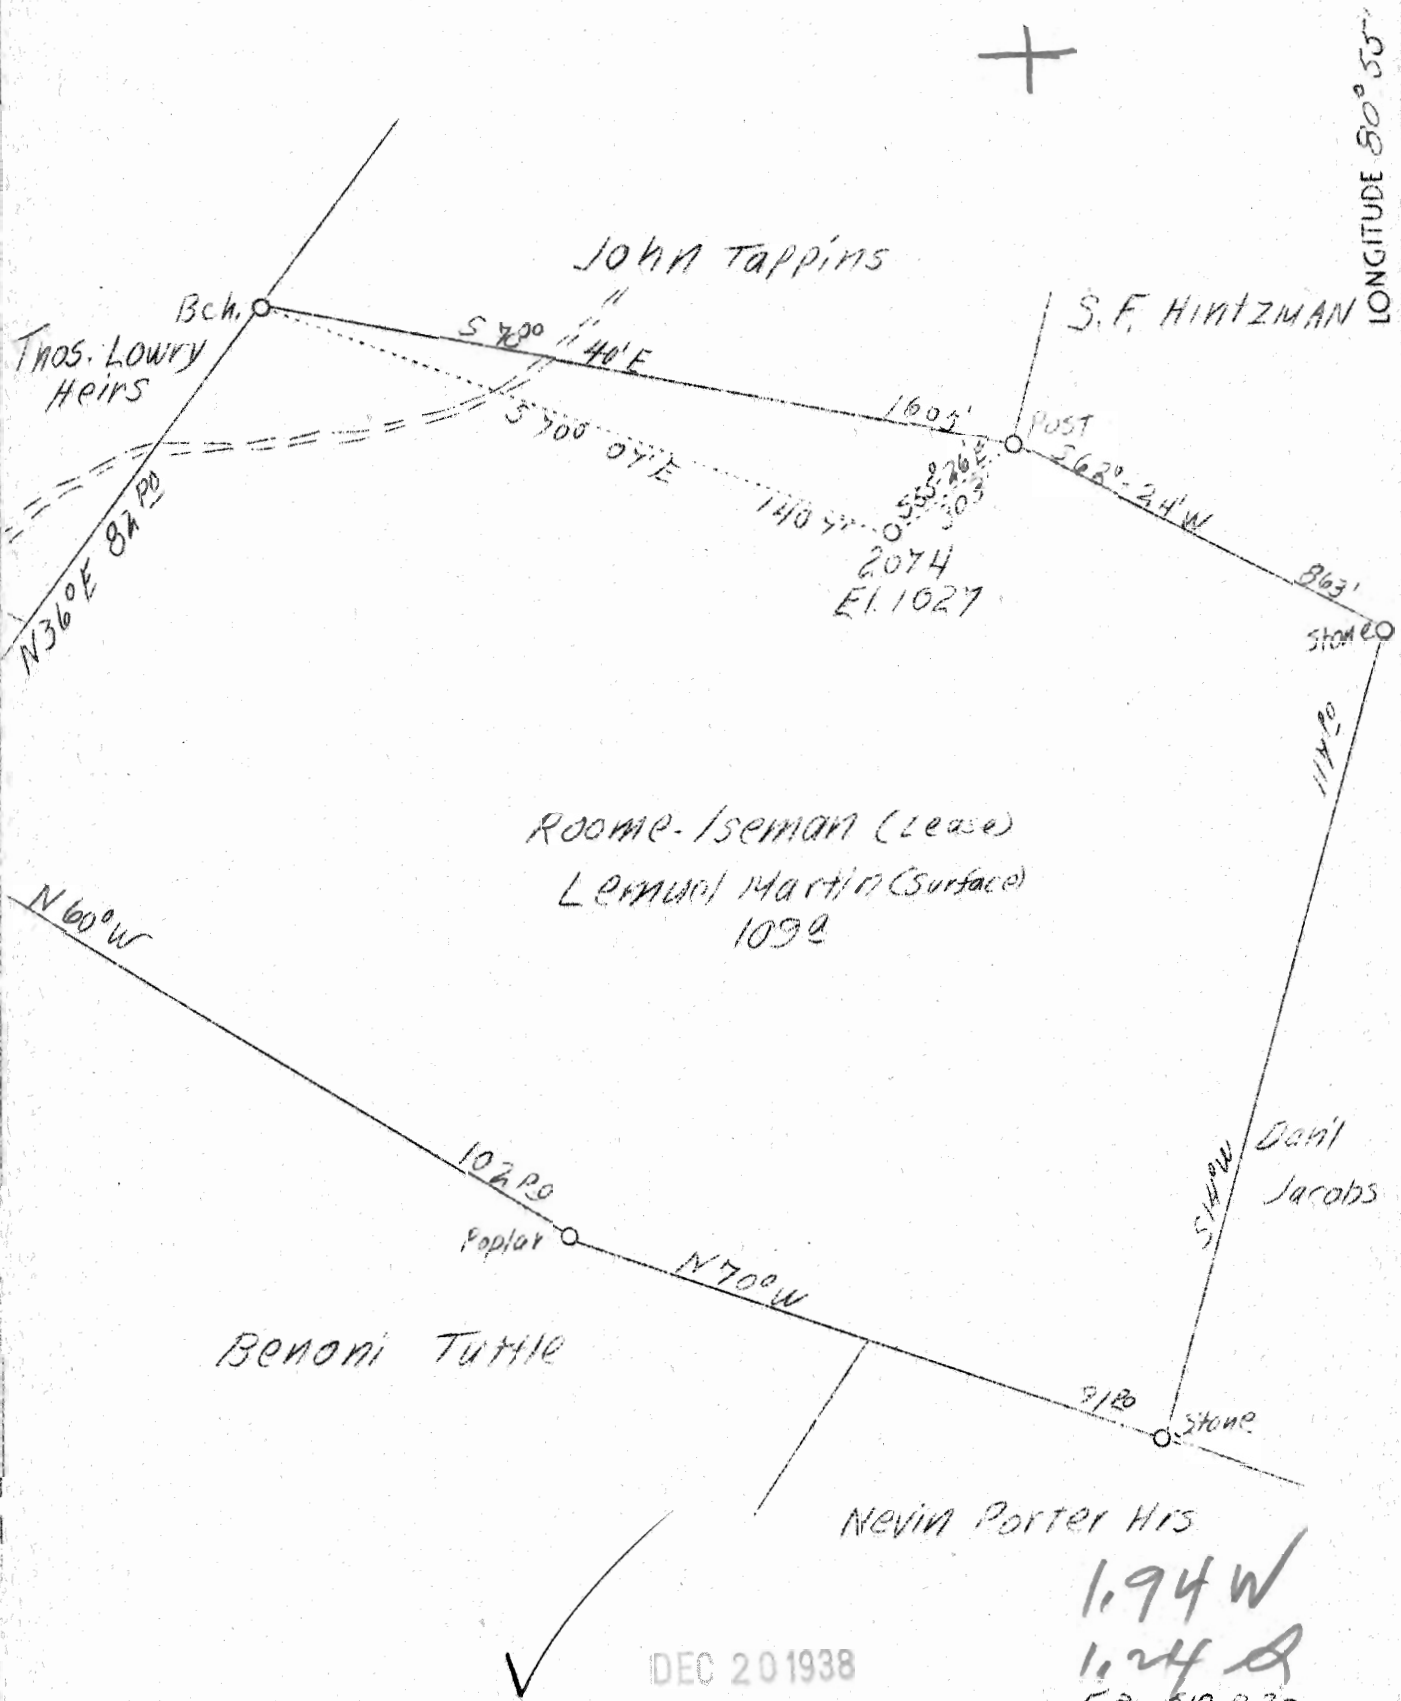

DEC 20 1938

1.94 W
1.24 A
F.D. 518 P 20

Company	Hope Cons'n & Ref. Co.
Address	Clarksburg, W.Va.
Farm	Roome - Iseman
Acres	109
Lease No.	6096
Serial No.	2074
E. (Spirit Level)	1027
Quadrangle	New Martinsville
County	Tyler
District	Lincoln
Eng.	W.M. Bowers
Eng. Reg. No.	900
Scale	1" = 400'

SW

STATE OF WEST VIRGINIA
 Department of Mines
 OIL AND GAS DIVISION
 Charleston

WELL LOCATION MAP

File No. TY-192-A

x Denotes location of well on U.S. Topographic Maps, scale 1 to 62,500, latitude and longitude lines being represented by border lines as shown.

- Denotes one inch spaces on border line of original tracing.

STATE OF WEST VIRGINIA
DEPARTMENT OF MINES
OIL AND GAS DIVISION

280

WELL RECORD

Permit No. AP-192-A.

Oil or ~~Gas~~ Well Oil
(Kind)

Company Hode Construction & Refining Co.
Address 445 West Main St. Clarksburg, W. Va.
Farm Roone-Isman Acres 109
Location (waters) Pole Cat Run
Well No. 2074 Elev. 1027'
District Lincoln County Tyler
The surface of tract is owned in fee by _____
Address _____
Mineral rights are owned by _____
Address _____
Drilling commenced No record
Drilling completed No record
Date shot 1898 Depth of shot _____
Open Flow /10ths Water in _____ Inch
/10ths Merc. in _____ Inch
Volume _____ Cu. Ft.
Rock Pressure _____ lbs. _____ hrs.
Oil _____ bbls., 1st 24 hrs.
Fresh water None recorded feet _____ feet
Salt water None recorded feet _____ feet

Casing and Tubing	Used in Drilling	Left in Well	Packers
Size			
16			Kind of Packer
13			
10			Size of
8 1/4	<u>288</u>	<u>288</u>	
6 5/8	<u>1505</u>	<u>1505</u>	Depth set
5 3/16			
3			Perf. top
2	<u>1883</u>	<u>1883</u>	Perf. bottom
Liners Used			Perf. top
			Perf. bottom

Not cemented
CASING CEMENTED _____ SIZE _____ No. FT. _____ Date _____
COAL WAS ENCOUNTERED AT 202 FEET 48 INCHES **Est.**
_____ FEET _____ INCHES FEET _____ INCHES
_____ FEET _____ INCHES FEET _____ INCHES

Formation	Color	Hard or Soft	Top	Bottom	Oil Gas or Water	Depth Found	Remarks
Pittsburgh	Coal		202	206 Est.			
First Salt	Sand		1392	1472			
Big Injun	Sand		1844	?	Oil	1862	
Total depth				1893			



Formation	Color	Hard or Soft	Top	Bottom	Oil, Gas or Water	Depth Found	Remarks

Date December 12, 1938, 19.....

APPROVED Hops Construction Refining Co owner

By [Signature] Gen. Supt.

(Title)