


LATITUDE 39° 35'

LONGITUDE 80° 55'

J. M. Dare

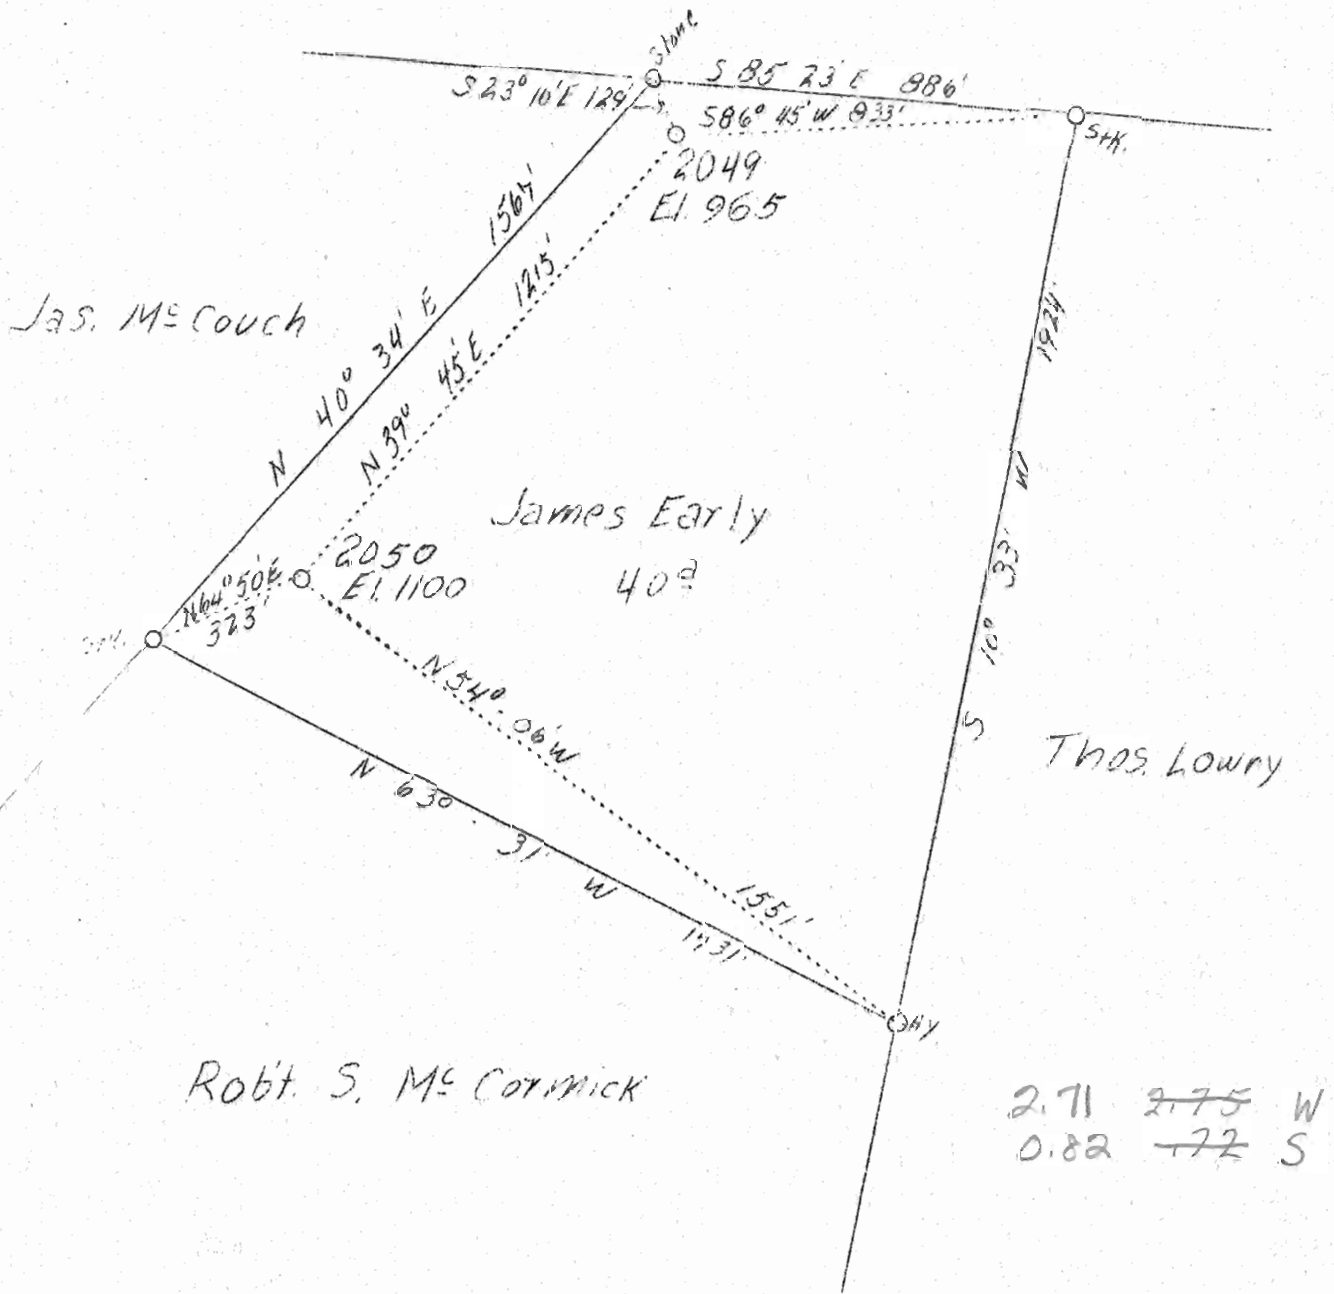

ABA 2050

F.B. 518 R 19420

Company	Hope Constr. & Refining Co.
Address	Clarksburg, W. Va.
Farm	James Early
Acres	40
Lease No.	6098
Well (Farm) No.	-
Series No.	2049-2050
Elevation (SP)	965-1100
Quadrangle	New Martinsville S.W.
County	Tyler
District	Union
Engineer	W. M. Bowers
Eng. Reg. No.	900
Date	Nov. 2, 1938
Scale	1" = 400'

STATE OF WEST VIRGINIA
 Department of Mines
 OIL & GAS DIVISION
 Charleston

WELL LOCATION MAP

File No. 111-108-A

x Denotes location of well on U. S. Topographic Maps, scale 1 to 62,500, latitude and longitude lines being represented by border lines as shown.

- Denotes one inch spaces on border line of original tracing.

STATE OF WEST VIRGINIA
DEPARTMENT OF MINES
OIL AND GAS DIVISION

WELL RECORD

279

Permit No. TYL 194-A

Oil or Gas Well
(Kind)

Company Hope Construction & Refining Company
 Address Clarksburg, W. Va.
 Farm James Early Acres 40
 Location (waters) 2049
 Well No. Union Elev. 965
 District Union County Tyler
 The surface of tract is owned in fee by _____
 Address _____
 Mineral rights are owned by _____
 Address _____
 Drilling commenced 6-25-1893
 Drilling completed In 1893
 Date shot 8-1-1927 Depth of shot In Injun
 Open Flow /10ths Water in _____ Inch
 /10ths Merc. in _____ Inch
 Volume _____ Cu. Ft.
 Rock Pressure _____ lbs. _____ hrs.
 Oil _____ bbls., 1st 24 hrs.
 Fresh water None recorded feet _____ feet
 Salt water None recorded feet _____ feet

Casing and Tubing	Used in Drilling	Left in Well	Packers
Size			
16			Kind of Packer
13			
10			Size of
8 1/4			
6 5/8			Depth set
5 3/16			
# 4-7/8"	1550	1550	Perf. top
2	1790	1790	Perf. bottom
Liners Used			Perf. top
			Perf. bottom

CASING CEMENTED _____ SIZE _____ No. FT. _____ Date _____
 Not cemented
 /calculated COAL WAS ENCOUNTERED AT 85 FEET 48 INCHES
 FEET INCHES FEET INCHES
 FEET INCHES FEET INCHES

Formation	Color	Hard or Soft	Top	Bottom	Oil Gas or Water	Depth Found	Remarks
Pittsburgh Coal		(Calculated)	85	89			
Salt Sand		(Calculated)	1010	1135			
Big Lime		(Calculated)	1648				
Big Injun Sand			1732		Oil	1750	
Total Depth				1800			



Formation	Color	Hard or Soft	Top	Bottom	Oil, Gas or Water	Depth Found	Remarks

Date January 5, 1939

APPROVED Hope Construction & Refining Co. Owner

By W. Reed General Supt.
(Title) WR