


LATITUDE 39° 30'

LONGITUDE 81° 00'

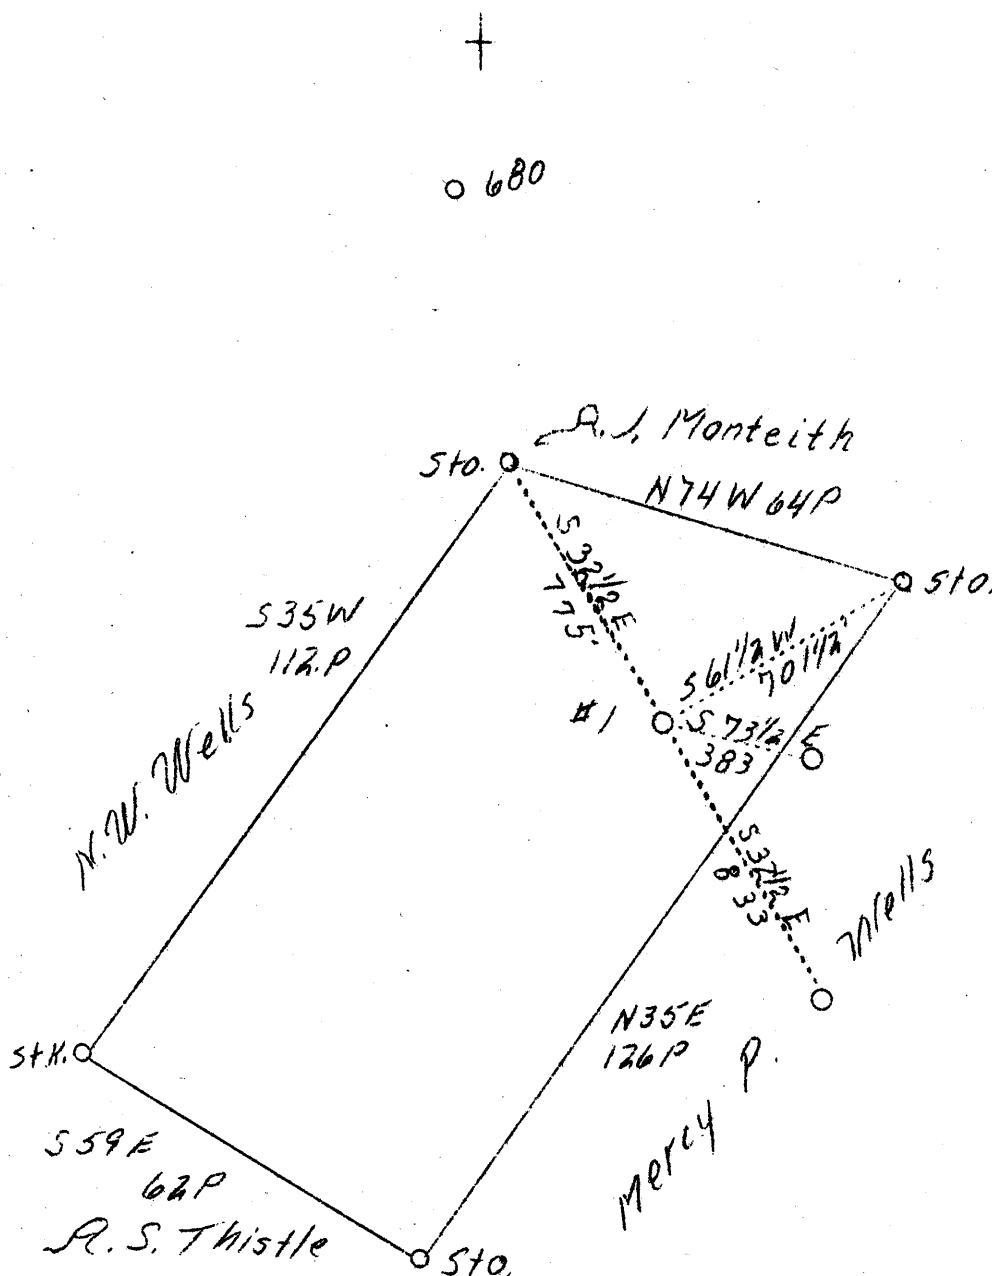

4.42 4.5 W
1.75 A

ABD.

SEP 12 1939

Company	Warden & Failnoir <i>Fulmer</i>
Address	New Matamoris, Ohio
Farm	Blanche H. Morris
Tract	1
Acres	45
Well (Farm) No.	1
El. (S.L.)	795.33
Quadrangle	St. Marys
County	Tyler
District	Union
Eng.	J.S. Haught
Eng. Reg. No.	Co. Surv ¹
Date	8/19/39
Scale	1" - 30 Rods

STATE OF WEST VIRGINIA
Department of Mines
OIL AND GAS DIVISION
Charleston

WELL LOCATION MAP

File No. TVI-211-A

x Denotes location of well on U.S. Topographic Maps, scale 1 to 62,500, latitude and longitude lines being represented by border lines as shown.

- Denotes one inch spaces on border line of original tracing.

STATE OF WEST VIRGINIA
DEPARTMENT OF MINES
OIL AND GAS DIVISION

294

WELL RECORD

Permit No. 211-A

Oil or Gas Well. *Oil*
(Kind)

Company *Warden and Fulmer*
Address *New Matamoras, Ohio*
Farm *Blanche F. Morris* Acres *45*
Location (waters) _____
Well No. _____ Elev. *795.33*
District *Union* County *Dyer*
The surface of tract is owned in fee by *Blanche Morris*
Address *Harrisville*
Mineral rights are owned by *Blanche Morris*
Address *Harrisville*
Drilling commenced *June 1920*
Drilling completed *Aug 1920*
Date shot *Aug 1920* Depth of shot *1578-1584*
Open Flow *10ths* Water in _____ Inch
/10ths Merc. in _____ Inch
Volume *Estimated 25-thousand* Cu. Ft.
Rock Pressure _____ lbs. _____ hrs.
Oil *1/2* _____ bbls., 1st 24 hrs.
Fresh water _____ feet _____ feet
Salt water _____ feet *1578-1584* feet

Casing and Tubing	Used in Drilling	Left in Well	Packers
Size			Kind of Packer
16			
13			
10			Size of <i>None</i>
8 1/4	<i>720</i>		
6 1/4	<i>1120</i>	<i>1120</i>	Depth set
5 3/16			
5			Perf. top
2			Perf. bottom
Liners Used			Perf. top
			Perf. bottom

CASING CEMENTED _____ SIZE _____ No. Ft. _____ Date _____
COAL WAS ENCOUNTERED *None* FEET _____ INCHES _____
FEET _____ INCHES _____ FEET _____ INCHES
FEET _____ INCHES _____ FEET _____ INCHES

Formation	Color	Hard or Soft	Top	Bottom	Oil, Gas or Water	Depth Found	Remarks
<i>Cave</i>	<i>red</i>	<i>soft</i>	<i>465</i>	<i>570</i>			
<i>Cave</i>	<i>red</i>	<i>soft</i>	<i>630</i>	<i>660</i>			
<i>Cow Run</i>		<i>hard</i>	<i>660</i>	<i>680</i>			<i>Broken</i>
<i>Cave</i>	<i>red</i>	<i>soft</i>	<i>680</i>	<i>720</i>			
<i>Thin Salt</i>		<i>hard</i>	<i>1157</i>	<i>1260</i>			
<i>Mapon</i>			<i>1380</i>	<i>1402</i>	<i>gas</i>	<i>1385-1390</i>	<i>25-thous.</i>
<i>Big Lime</i>		<i>hard</i>	<i>1420</i>	<i>1520</i>			
<i>Keenser</i>		<i>soft</i>	<i>1520</i>	<i>1555</i>			
<i>Slate</i>	<i>dark</i>	<i>soft</i>	<i>1555</i>	<i>1577</i>			
<i>Big Injin</i>		<i>hard</i>	<i>1578</i>	<i>1594</i>	<i>Oil</i>	<i>1578-1584</i>	
<i>Total depth</i>				<i>1594</i>			

