

New Location
 Drill Deeper
 Abandonment

Company W. Moses,
 Address Galeton, W. Va.
 Farm Hardman, H. H. et al.
 Tract 0.726 Acres 916 Lease No. _____
 Well (Farm) No. 39 & 46 Serial No. _____
 Elevation (Spirit Level) Elev. 1016 No. 39 No. 46 Elev. 1122
 Quadrangle Centerpoint
 County Tyler District McElroy
 Engineer J. M. Mason
 Engineer's Registration No. 84
 File No. _____ Drawing No. _____
 Date May 1, 1940 Scale 100 P = 1 Inch

STATE OF WEST VIRGINIA
 DEPARTMENT OF MINES
 OIL AND GAS DIVISION
 CHARLESTON

WELL LOCATION MAP
 FILE NO. TYL-249A-250A
 39 46

+ Denotes location of well on United States Topographic Maps, scale 1 to 62,500, latitude and longitude lines being represented by border lines as shown.
 - Denotes one inch spaces on border line of original tracing.

STATE OF WEST VIRGINIA
DEPARTMENT OF MINES
OIL AND GAS DIVISION

307

Ab 250-A

WELL RECORD


Oil or Gas Well... Oil
(Kind)

Permit No. 5260
Company... William Moses
Address... 189 Main St., Salem, W. Va.
Farm... H. H. Hardman, et al Acres
Location (waters)
Well No. 46 Elev. 1122
District... Weybroy County... Tyler
The surface of tract is owned in fee by... Murphy Oil Co.
Mineral rights are owned by... H. H. Hardman, et al, c/o
A. L. Anderson, adm'r. Address... Friendly, W. Va.
Drilling commenced
Drilling completed
Date shot... Depth of shot...
Open Flow /10ths Water in... Inch
/10ths Merc. in... Inch
Volume... Cu. Ft.
Rock Pressure... lbs... hrs.
Oil... bbls., 1st 24 hrs.
Fresh water... feet... feet
Salt water... feet... feet

| Casing and Tubing | Used in Drilling | Left in Well | Packers |
|-------------------|------------------|--------------|----------------|
| Size | | | |
| 16 | | | Kind of Packer |
| 13 | | | |
| 10 | | | Size of |
| 8 1/4 | | | |
| 6 3/8 | | 1665' | Depth set |
| 5 3/16 | | | |
| 3 | | | Perf. top |
| 2 | | 2103' | Perf. bottom |
| Liners Used | | | Perf. top |
| | | | Perf. bottom |

CASING CEMENTED... SIZE... No. Ft... Date
COAL WAS ENCOUNTERED AT 340 FEET INCHES
FEET INCHES FEET INCHES
FEET INCHES FEET INCHES

| Formation | Color | Hard or Soft | Top | Bottom | Oil, Gas or Water | Depth Found | Remarks |
|----------------------------------|-------|--------------|------|--------|-------------------|-------------|---------|
| Pittsburgh Coal | | | 640 | | | | |
| Big Dunkard | | | 1245 | | | | |
| Salt Sand | | | 1407 | | | | |
| Big Lime | | | 1662 | | | | |
| Big Engine | | | 2045 | 2117 | | | |
| Total Depth | | | 2137 | | | | |
| No coal operations in this area. | | | | | | | |

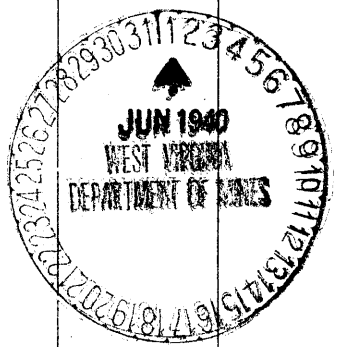

| Formation | Color | Hard or Soft | Top | Bottom | Oil, Gas or Water | Depth Found | Remarks |
|-----------|-------|--------------|-----|--------|-------------------|-------------|---------|
| | | | | | | | |

Date....., 19.....

APPROVED....., Owner

By.....
(Title)