

30264


Pleasants

TYLER Latitude 39° 30'

Pleasant #5	2.38 S	0.17 W
Pleasant #1	2.48 S	0.01 W
Pleasant #2	2.43 S	0.08 W
Pleasant #7	2.28 S	0.09 W

#1	2.44 S	0.22 W
#2	2.37 S	0.22 W
#6	2.31 S	0.17 W

Smith

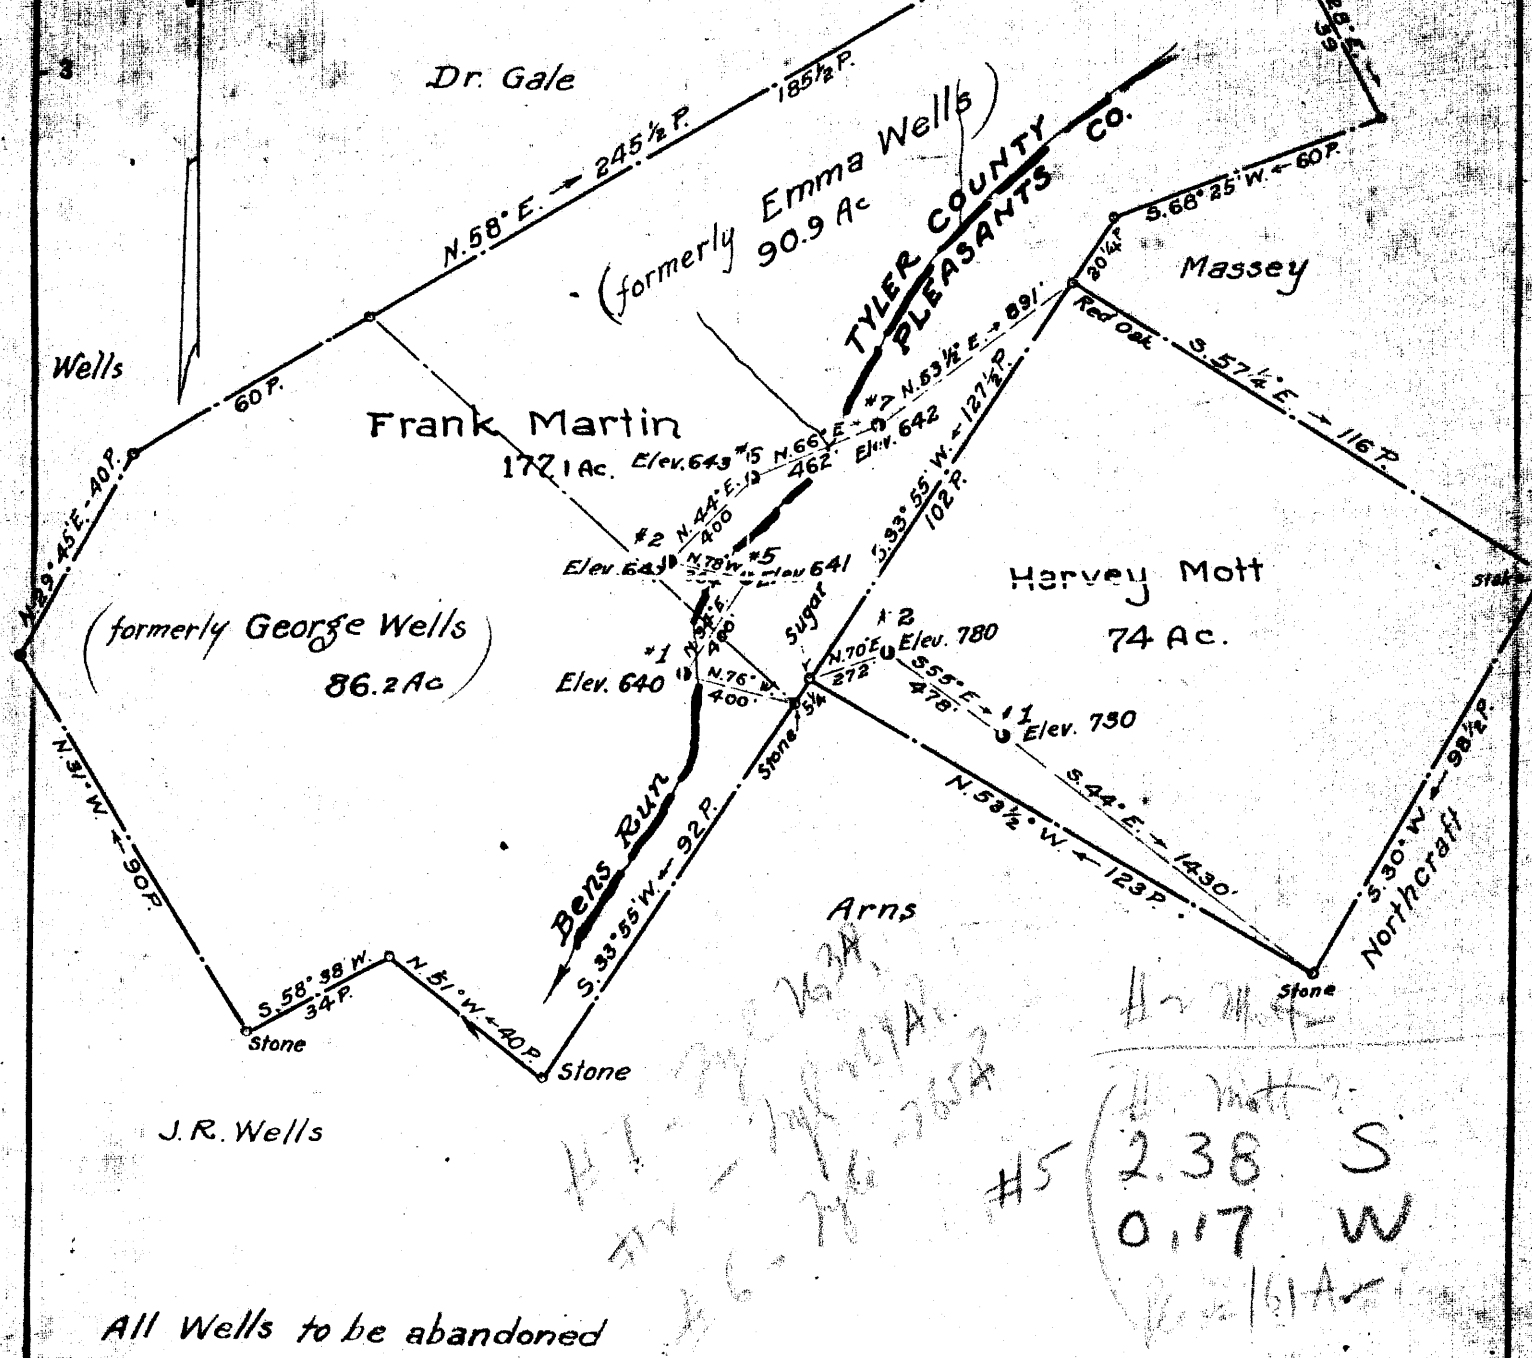

Company Newman & Devitt
 Address Stockport, Ohio
 Farm Harvey Mott Nos 1 & 2
Frank Martin Nos 1, 2, 5, 6 & 7
 Tract _____ Acres 177.1 Lease No. _____
 Well (Farm) No. _____ Serial No. _____
 Elevation (Spirit Level) As shown above
 Quadrangle St. Marys, W. Va
 County TYLER District Union
 Engineer Parker & Peter
 Engineer's Registration No. 485
 File No. _____ Drawing No. _____
 Date Sept. 21, 1940 Scale 1" = 40 Poles

STATE OF WEST VIRGINIA
 DEPARTMENT OF MINES
 OIL AND GAS DIVISION
 CHARLESTON

WELL LOCATION MAP
 FILE NO. Pleasant #1-A
TY-263-A

+ Denotes location of well on United States Topographic Maps, scale 1 to 62,500, latitude and longitude lines being represented by border lines as shown.
 - Denotes one inch spaces on border line of original tracing.

STATE OF WEST VIRGINIA
DEPARTMENT OF MINES
OIL AND GAS DIVISION

315

WELL RECORD

Permit No. TYL-264-A

Oil or Gas Well.....
(KIND)

Company..... Newman & DeWitt 497
Address..... Stockport, Ohio
Farm..... Frank Martin Acres.....
Location (waters).....
Well No..... 2 Elev.....
District..... Union County..... Tyler
The surface of tract is owned in fee by.....
Address.....
Mineral rights are owned by..... Frank Martin
Address..... Bons Run, W. Va.
Drilling commenced.....
Drilling completed.....
Date shot..... Depth of shot.....
Open Flow /10ths Water in..... Inch
/10ths Merc. in..... Inch
Volume..... Cu. Ft.
Rock Pressure..... lbs..... hrs.
Oil..... bbls., 1st 24 hrs.
Fresh water..... feet..... feet
Salt water..... feet..... feet

Casing and Tubing	Used in Drilling	Left in Well	Packers
Size			Kind of Packer.....
16.....			
13.....			
10.....			Size of.....
8 1/4.....			
6 1/4.....	1050'		Depth set.....
5 3/16.....			
3.....			Perf. top.....
2.....			Perf. bottom.....
Liners Used.....			Perf. top.....
			Perf. bottom.....

CASING CEMENTED..... SIZE..... No. Ft..... Date.....
COAL WAS ENCOUNTERED AT..... FEET..... INCHES
..... FEET..... INCHES..... FEET..... INCHES
..... FEET..... INCHES..... FEET..... INCHES

Formation	Color	Hard or Soft	Top	Bottom	Oil, Gas or Water	Depth Found	Remarks
<u>Maxon Sand</u>				<u>1450'</u>			
<u>Total Depth</u>				<u>1450'</u>			

