


30273

2282 1229

(2061) Latitude 2056 3360

39 35

#1229	5.71 S	39°40' 3
266-A	2.58 W	
#2282	5.76 S	39°40
#268A	2.67 W	
#3360	0.29 S	
#273A	2.72 W	
#2068	0.19 S	
#277A	2.60 W	
#2056	0.11 S	
#286A	2.98 W	

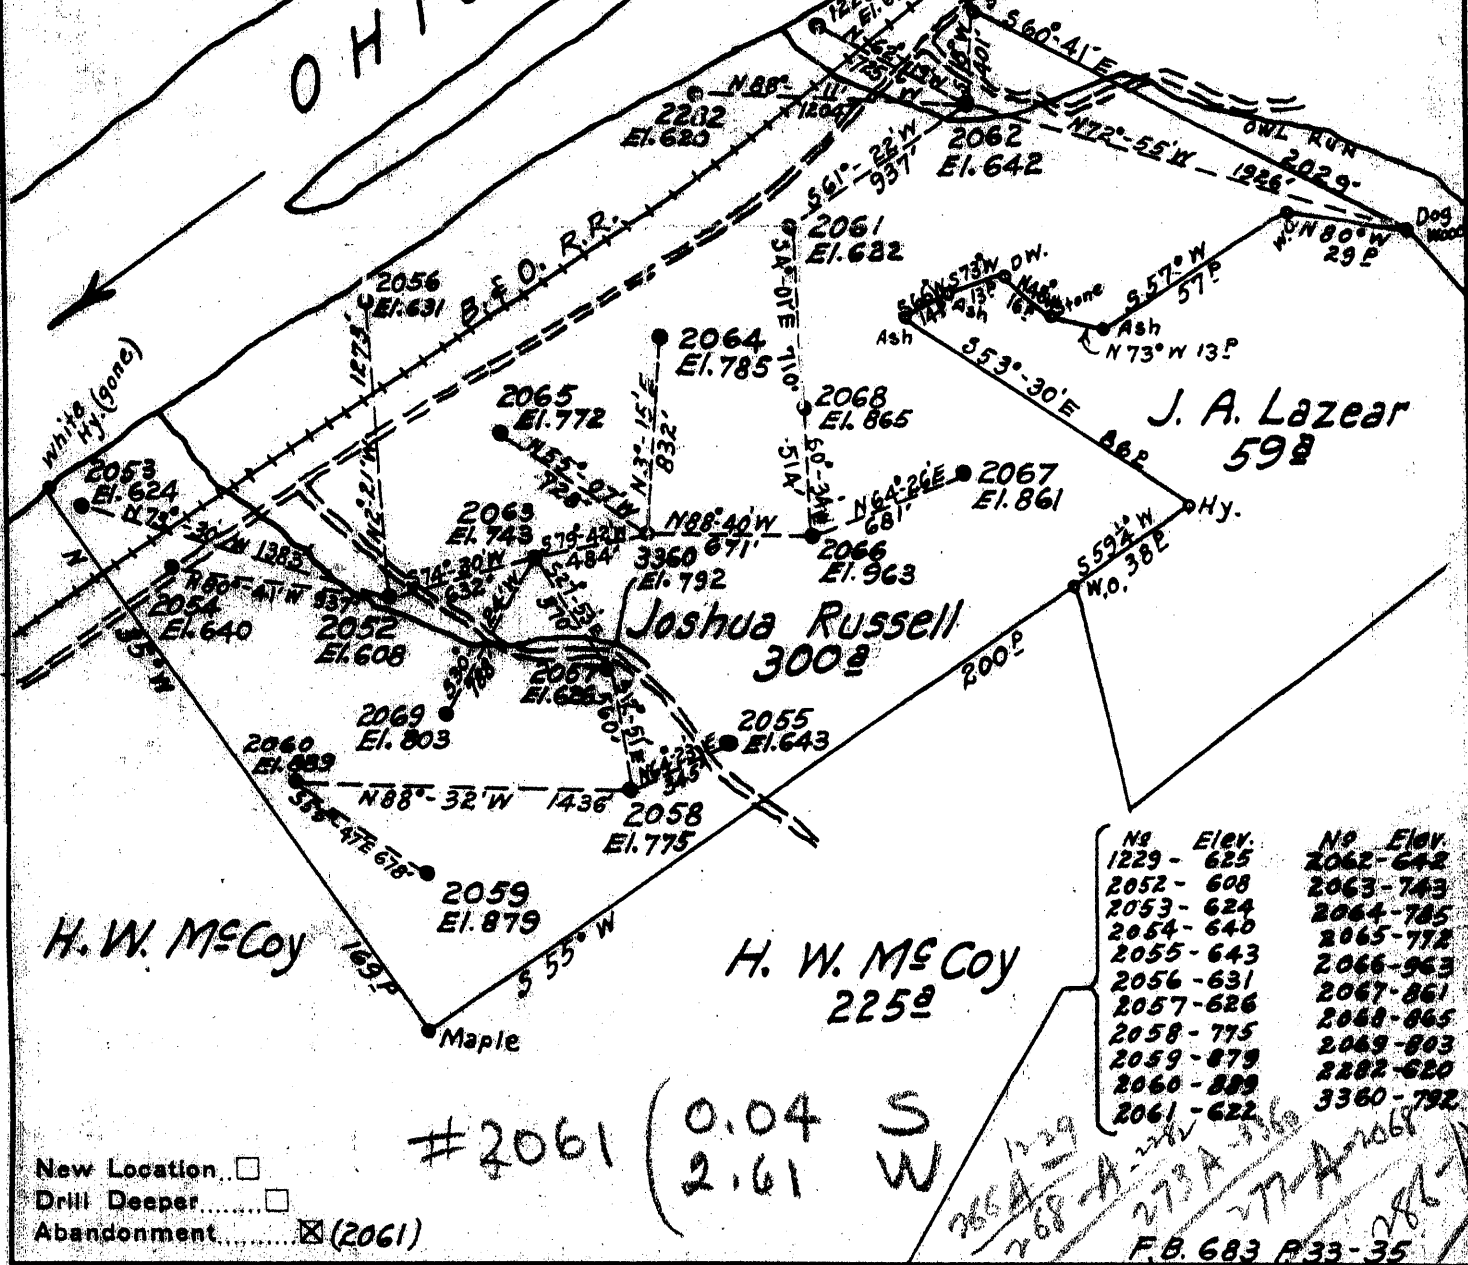

#2061 (0.04 S, 2.61 W)

New Location
Drill Deeper
Abandonment (2061)

Company Hope Const. & Refining Co.
 Address Clarksburg, W. Va.
 Farm Joshua Russell
 Tract Acres 300 Lease No. 6092
 Well (Farm) No. _____ Serial No. _____
 Elevation (Spirit Level) _____
 Quadrangle New Martinsville SW
 County Tyler District Lincoln
 Engineer W. M. Brown
 Engineer's Registration No. 900
 File No. _____ Drawing No. _____
 Date May 29, 1940 Scale 1" = 50'

STATE OF WEST VIRGINIA
DEPARTMENT OF MINES
OIL AND GAS DIVISION
CHARLESTON

WELL LOCATION MAP
FILE NO. TYL-248A/250A
2062

+ Denotes location of well on United States Topographic Maps, scale 1 to 62,500, latitude and longitude lines being represented by border lines as shown.
- Denotes one inch spaces on border line of original tracing.

Wells associated with plat for 47-095-30-248

Well number	file number
1229	216 a
2061	248a
2062	254a
2282	268a
3360	273a ✓
2068	277a
2056	286a