

Company American Oil Development Company
 Address Sistersville West Virginia
 Farm James Gray
 Tract 46² Acres 100 Lease No. _____
 Well (Farm) No. 1 and 2 Serial No. _____
 Elevation (Spirit Level) 1-1045.62 2-1057.44
 Quadrangle Center point
 County Tyler District McElroy
 Engineer J.S. [unclear]
 Engineer's Registration No. County Surveyor Tyler-co
 File No. _____ Drawing No. _____
 Date 4-22-41 Scale 20 rds = 1 inch

STATE OF WEST VIRGINIA
 DEPARTMENT OF MINES
 OIL AND GAS DIVISION
 CHARLESTON

WELL LOCATION MAP
 FILE NO. TYL-288A-289A
 1 2

+ Denotes location of well on United States Topographic Maps, scale 1 to 62,500, latitude and longitude lines being represented by border lines as shown.

- Denotes one inch spaces on border line of original tracing.

JAMES GRAY NOS. 1 & 2 - AMERICAN OIL DEV. CO. - TYL-288-A & 289-

STATE OF WEST VIRGINIA
DEPARTMENT OF MINES
OIL AND GAS DIVISION

328

AB 289-A

WELL RECORD


Oil or Gas Well **Oil Well**
(Kind)

Permit No. **011**
Company **American Development Co.,**
Address **Sistersville, West Virginia**
Farm **James Gray** Acres **100**
Location (waters) **Davis Run**
Well No. **Two** Elev. **1067.44**
District **McHenry** County **Tyler**
The surface of tract is owned in fee by **G. C. George**
Address **Lima, W. Va.**
Mineral rights are owned by **Mary George et al,**
Mary George Atty., Address **Lima, W. Va.**
Drilling commenced
Drilling completed
Date shot **October 1896** Depth of shot **2136**
Open Flow /10ths Water in _____ Inch
/10ths Merc. in _____ Inch
Volume _____ Cu. Ft.
Rock Pressure _____ lbs. _____ hrs.
Oil _____ bbls., 1st 24 hrs.
Fresh water _____ feet _____ feet
Salt water _____ feet _____ feet

Casing and Tubing	Used in Drilling	Left in Well	Packers
Size			
16.			Kind of Packer
13.			
10.			Size of
8 1/4			
6 5/8		2012	Depth set
5 3/16			
3.			Perf. top
2.			Perf. bottom
Liners Used			Perf. top
			Perf. bottom

CASING CEMENTED _____ SIZE _____ No. FT. _____ Date _____
COAL WAS ENCOUNTERED AT _____ FEET _____ INCHES
_____ FEET _____ INCHES FEET _____ INCHES
_____ FEET _____ INCHES FEET _____ INCHES

Formation	Color	Hard or Soft	Top	Bottom	Oil Gas or Water	Depth Found	Remarks
Big Injun			2080		Oil		
T. Depth						2136	
<p>Well Purchased from New York Petroleum Company, October 1st, 1934. Stated above, is the only available record of this well.</p>							

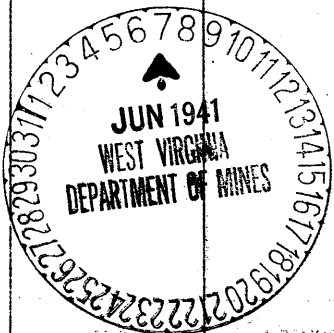

JUL 13 1941

