

New Location
 Drill Deeper
 Abandonment..... X

Company American Oil Development Co.
 Address Sistersville, West Virginia
 Farm J.W. Headley
 Tract _____ Acres 45[±] Lease No. _____
 Well (Farm) No. 2-3-4 Serial No. _____
 Elevation (Spirit Level) 2-1153.54
 Quadrangle Center 2-1
 County Tyler District McIntosh
 Engineer J.S. Haughton
 Engineer's Registration No. CO Surveyor
 File No. _____ Drawing No. _____
 Date 5-27-41 Scale AS SHOWN

STATE OF WEST VIRGINIA
 DEPARTMENT OF MINES
 OIL AND GAS DIVISION
 CHARLESTON

WELL LOCATION MAP
 FILE NO. TYL-291-2-3A
 2 3 4

+ Denotes location of well on United States Topographic Maps, scale 1 to 62,500, latitude and longitude lines being represented by border lines as shown.
 - Denotes one inch spaces on border line of original tracing.

J.W. HEADLEY 1105, 2-3-4 - (AMERICAN OIL DEVEL. CO.) - TYL-291-A

STATE OF WEST VIRGINIA
DEPARTMENT OF MINES
OIL AND GAS DIVISION

330

WELL RECORD

AP 24-1-A
Permit No.


Oil or Gas Well Oil Well
(Kind)

Company American Oil Development Company
Address Sistersville, West Virginia
Farm J. W. Headley Acres 45
Location (waters) Bonalick Run
Well No. Three (3) Elev. 1133.58
District McElroy County Tyler
The surface of tract is owned in fee by B. W. Headley
Address Lima, W. Va.
Mineral rights are owned by B. W. Headley
Address Lima, W. Va.
Drilling commenced.....
Drilling completed.....
Date shot..... Depth of shot.....
Open Flow /10ths Water in..... Inch
/10ths Merc. in..... Inch

Casing and Tubing	Used in Drilling	Left in Well	Packers
Size			
16.....			Kind of Packer.....
13.....			
10.....			Size of.....
8 1/4.....			
6 5/8.....			Depth set.....
5 3/16.....			
3.....			Perf. top.....
2.....			Perf. bottom.....
Liners Used.....			Perf. top.....
			Perf. bottom.....

Volume..... Cu. Ft. CASING CEMENTED..... SIZE..... No. FT..... Date
Rock Pressure..... lbs..... hrs.
Oil..... bbls., 1st 24 hrs. COAL WAS ENCOUNTERED AT..... FEET..... INCHES
Fresh water..... feet..... feet..... FEET..... INCHES
Salt water..... feet..... feet..... FEET..... INCHES

Formation	Color	Hard or Soft	Top	Bottom	Oil Gas or Water	Depth Found	Remarks
<p>This well was purchased from New York Petroleum Company, October, 1934.</p> <p>There is no available record for this well.</p>							

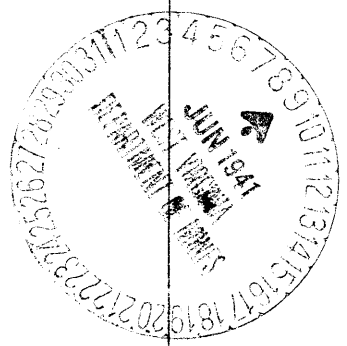

(Over)

JUN 13 1941

Formation	Color	Hard or Soft	Top	Bottom	Oil, Gas or Water	Depth Found	Remarks

Date **June 7th**, 19 **41**

APPROVED **American Oil Development Co.**, Owner

By *John P. Kelly*
(Title)