

COAL OWNED BY LAURA MAYFIELD R.D. 5 WAYNESBURG PA.

NEW LOCATION  
 DRILL DEEPER  
 ABANDONMENT

OCT 21 1944

COMPANY THE MANUFACTURERS LIGHT AND HEAT CO.  
 ADDRESS 800 UNION TRUST BLDG. PITTSBURGH PA.  
 NAME LAURA MAYFIELD  
 ACREAGE 23 LEASE NO. 2956  
 WELL (FARM) NO. 1 SERIAL NO. 1917  
 ELEVATION (SPIRIT LEVEL) 1105  
 QUADRANGLE WEST UNION  
 COUNTY TYLER DISTRICT MCELROY  
 ENGINEER J. L. HENNINGER  
 ENGINEER'S REGISTRATION NO.  
 DRAWING NO. Y-11-74  
 DATE OCTOBER 5 1944 SCALE 1" = 400'


STATE OF WEST VIRGINIA  
 DEPARTMENT OF MINES  
 OIL AND GAS DIVISION  
 CHARLESTON  
 WELL LOCATION MAP  
 FILE NO. Ty 1-378-A

INDICATES LOCATION OF WELL ON UNITED STATES TOPO-  
 GRAPHIC MAP. SCALE 1" TO 40 500' LATITUDE AND LONGITUDE  
 LINES DRAWN AND REPRESENTED BY DOTTED LINES AS SHOWN  
 SCALE INCH TO FEET OF EITHER THE ORIGINAL

LAURA MAYFIELD No. 1 (1917) - M. L. & H. Co. - TYL-378-A



STATE OF WEST VIRGINIA  
DEPARTMENT OF MINES  
OIL AND GAS DIVISION

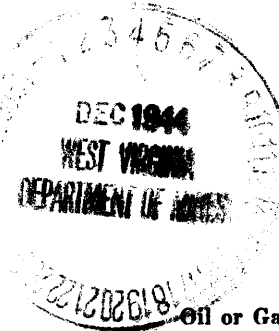

369

WELL RECORD

Permit No. Drilled in 1919

Oil or Gas Well Gas  
(KIND)

Company The Manufacturers Light & Heat Company  
Address 800 Union Trust Bldg., Pittsburgh, Pa.  
Farm Laura E. Mayfield Acres 23  
Location (waters) \_\_\_\_\_  
Well No. 2 - 1917 Elev. 1105  
District McElroy County Tyler  
The surface of tract is owned in fee by Ingram Myers  
Address New Martinsville WVa  
Mineral rights are owned by The Mfrs Light & Heat Co  
800 Union Trust Bldg. Address Pittsburgh, Pa.  
Drilling commenced May 5th, 1916  
Drilling completed June 22nd, 1916  
Date Shot \_\_\_\_\_ From \_\_\_\_\_ To \_\_\_\_\_  
With \_\_\_\_\_  
Open Flow \_\_\_\_\_ /10ths Water in \_\_\_\_\_ Inch  
\_\_\_\_\_ /10ths Merc. in \_\_\_\_\_ Inch  
Volume \_\_\_\_\_ Cu. Ft.  
Rock Pressure \_\_\_\_\_ lbs. \_\_\_\_\_ hrs.  
Oil \_\_\_\_\_ bbls., 1st 24 hrs.  
Fresh water \_\_\_\_\_ feet \_\_\_\_\_ feet  
Salt water \_\_\_\_\_ feet \_\_\_\_\_ feet

Casing and Tubing	Used in Drilling	Left in Well	Packers
Size			
16			Kind of Packer
13			
10	123'		Size of
8 1/4	122 1/4' 1"	122 1/4' 1"	
6 3/4	1956' 1"	1956' 1"	Depth set
5 3/16			
3			Perf. top
2			Perf. bottom
Liners Used			Perf. top
			Perf. bottom

CASING CEMENTED \_\_\_\_\_ SIZE \_\_\_\_\_ No. Ft. \_\_\_\_\_ Date \_\_\_\_\_  
COAL WAS ENCOUNTERED AT 660 FEET 36 INCHES  
94 FEET 36 INCHES FEET INCHES  
FEET INCHES FEET INCHES

Formation	Color	Hard or Soft	Top	Bottom	Oil, Gas or Water	Depth Found	Remarks
Clay & Slate			0	30			
Red Rock			30	94			
Coal			94	97			
Sand			97	115			
Red Rock			115	134			
Lime			134	172			
Slate			172	214			
Lime			214	236			
Red Rock			236	270			
Sand			270	290			
Slate			290	343			
Lime			343	400			
Slate			400	432			
Coal			432	434			
Slate			434	462			
Red Rock			462	500			
Sand			500	545			
Slate			545	578			
Red Rock			578	652			
Lime			652	660			
Pittsburgh Coal			660	663			
Slate & Lime			663	730			
Sand			730	762			
Slate			762	858			
Red Rock			858	880			
Lime			880	942			
Red Rock			942	976			
Lime			976	1041			
Slate			1041	1080			
Little Dunkard			1080	1114			
Slate			1114	1170			
Big Dunkard			1170	1198			
Slate			1198	1205			
Sand			1205	1236			
Slate & Lime			1236	1274			
Sand			1274	1316			
Slate & Lime			1316	1342			
Sand			1342	1389			
Slate & Lime			1389	1425			

Formation	Color	Hard or Soft	Top	Bottom	Oil, Gas or Water	Depth Found	Remarks
Sand			1125	1138			
Slate & Shells			1138	1190			
1st Salt Sand			1190	1595			
Slate			1595	1612			
2nd Salt Sand			1612	1666	Water 1627		
Slate			1666	1739			
Sand			1739	1750			
Slate & Lime			1750	1784			
Maxon Sand			1784	1805			
Slate & Lime			1805	1878			
Little Lime			1878	1890			
Slate			1890	1900			
Pencil Cave			1900	1905			
Big Lime			1905	1976			
Big Injun Sand			1976	2198	Gas 2020 and 2063-2078		
Slate & Shells			2198	2334			
Sand			2334	2417			
Slate			2417	2430			
Lime			2430	2492			
Slate			2492	2544			
Slate & Shells			2544	2630			
Slate			2630	2762			
Gordon Sand			2762	2789	Gas 2779		
Slate			2789	2809			
Total depth				2809			

Date October 10th, 1944

APPROVED THE MANUFACTURERS LIGHT & HEAT COMPANY, Owner

By M. H. Fowler  
Land Dept. (Title) Office Mgr.  
W. C. W.