

New Location
 Drill Deeper
 Abandonment X

NOV - 5 1944

MAP SH. 47 SQ. N-6 W-13

Company HOPE NATURAL GAS CO.
 Address CLARKSBURG, W. VA.
 Farm JOSEPH WILLIAMS
 Tract _____ Acres 136 Lease No. 55515
 Well (Farm) No. _____ Serial No. 8946
 Elevation (Spirit Level) 951'
 Quadrangle NEW MARTINSVILLE
 County TYLER District ELLSWORTH
 Engineer W.M. Bowens
 Engineer's Registration No. 900
 File No. _____ Drawing No. _____
 Date 10-18-44 Scale 1" = 800'

STATE OF WEST VIRGINIA
 DEPARTMENT OF MINES
 OIL AND GAS DIVISION
 CHARLESTON

WELL LOCATION MAP

FILE NO. Tyl-379-A

+ Denotes location of well on United States Topographic Maps, scale 1 to 62,500, latitude and longitude lines being represented by border lines as shown.

- Denotes one inch spaces on border line of original tracing.



371

STATE OF WEST VIRGINIA
DEPARTMENT OF MINES
OIL AND GAS DIVISION

WELL RECORD

Permit No. 379-A


Oil or Gas Well (KIND)

Company Hope Natural Gas Company.
 Address 445 West Main St. Clarksburg, W. Va.
 Farm Joseph Williams Acres 136
 Location (waters) _____
 Well No. 8946 Elev. 950
 District Ellsworth County Tyler
 The surface of tract is owned in fee by _____
 Address _____
 Mineral rights are owned by _____
 Address _____
 Drilling commenced July 5, 1944
 Drilling completed August 7, 1944
 Date Shot _____ From _____ To _____
 With _____
 Open Flow _____ /10ths Water in _____ Inch
 _____ /10ths Merc. in _____ Inch
 Volume _____ Cu. Ft.
 Rock Pressure _____ lbs. _____ hrs.
 Oil _____ bbls., 1st 24 hrs.
 Fresh water none recorded feet _____ feet
 Salt water none recorded feet _____ feet

Casing and Tubing	Used in Drilling	Left in Well	Packers
Size			
16			Kind of Packer _____
13			
10	351	351	Size of _____
8 1/4	1130	1130	
6 5/8	1810	1810	Depth set _____
5 3/16			
3			Perf. top _____
2			Perf. bottom _____
Liners Used			Perf. top _____
			Perf. bottom _____

Not cemented
 CASING CEMENTED _____ SIZE _____ No. Ft. _____ Date _____
 COAL WAS ENCOUNTERED AT 380 FEET 36 INCHES
622 FEET 24 INCHES FEET INCHES
 FEET INCHES FEET INCHES

Formation	Color	Hard or Soft	Top	Bottom	Oil, Gas or Water	Depth Found	Remarks
Coal			380	383			
Coal			622	624			
Big Dunkard			1130	1168			
Gas sand			1330	1425			
First Salt			1430	1512			
Second Salt			1517	1555			
Maxon			1633	1671			
Little Lime			1734	1750			
Pencil cave			1750	1786			
Big Lime			1786	1865			
Keener sand			1865	1876	oil	1869 1874	
Big Injun			1876		gas	1920 1924	
Total depth				1924			

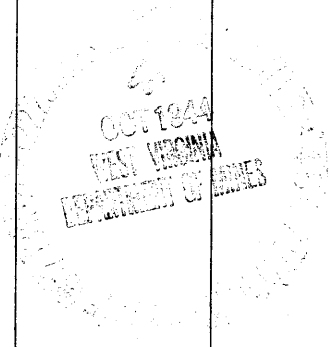

Formation	Color	Hard or Soft	Top	Bottom	Oil, Gas or Water	Depth Found	Remarks

Date October 16, 1944., 194

APPROVED Hope Natural Gas Company., Owner

By *[Signature]* Ass't. to Gen. Sup't.
(Title)

