

E.C. Riggs.
85 acres

JUL 21 1947

New Location
 Drill Deeper
 Abandonment

Company Dinsmoor Oil Co.
 Address St. Marys W.Va.
 Farm E. C. Riggs
 Tract _____ Acres 85 Lease No. _____
 Well (Farm) No. 1, 5, 7, & 18 Serial No. _____
 Elevation (Spirit Level) No. 1, 900' No. 5, 964' No. 7, 1100'
 Quadrangle West Union
 County Tyler District Meade
 Engineer Jno Triplett
 Engineer's Registration No. _____
 File No. _____ Drawing No. _____
 Date June 23, 1946 Scale 1" = 20 P.

STATE OF WEST VIRGINIA
 DEPARTMENT OF MINES
 OIL AND GAS DIVISION
 CHARLESTON

WELL LOCATION MAP
 JYL-432-A - #1
 FILE NO. JYL-433-A - #5
 JYL-434-A - #7
 JYL-435-A - #18
 + Denotes location of well on United States Topographic Maps, scale 1 to 62,500, latitude and longitude lines being represented by border lines as shown.
 - Denotes one inch spaces on border line of original tracing.



STATE OF WEST VIRGINIA
DEPARTMENT OF MINES
OIL AND GAS DIVISION

you

WELL RECORD

Permit No. 434-A

Oil or Gas Well (KIND)

Company Dinsmoor & Company
 Address St. Marys, W. Va.
 Farm E. C. Riggs Acres 85
 Location (waters) _____
 Well No. 7 Elev. 1100
 District Meade County Tyler
 The surface of tract is owned in fee by _____
 Address _____
 Mineral rights are owned by _____
 Address _____
 Drilling commenced _____
 Drilling completed 1899
 Date Shot _____ From _____ To _____
 With _____
 Open Flow _____ /10ths Water in _____ Inch
 _____ /10ths Merc. in _____ Inch
 Volume _____ Cu. Ft.
 Rock Pressure _____ lbs. _____ hrs.
 Oil _____ bbls., 1st 24 hrs.
 Fresh water _____ feet _____ feet
 Salt water _____ feet _____ feet

Casing and Tubing	Used in Drilling	Left in Well	Packers
Size			
16			Kind of Packer
13			
10			Size of
8 1/4			
7 1/2 6		1160	Depth set
5 3/16			
3			Perf. top
2			Perf. bottom
Liners Used			Perf. top
			Perf. bottom

CASING CEMENTED _____ SIZE _____ No. Ft. _____ Date _____


COAL WAS ENCOUNTERED AT _____ FEET _____ INCHES

_____ FEET _____ INCHES _____ FEET _____ INCHES

_____ FEET _____ INCHES _____ FEET _____ INCHES

Formation	Color	Hard or Soft	Top	Bottom	Oil, Gas or Water	Depth Found	Remarks
<u>Pay</u>				1181			
<u>Total Depth</u>				1215			

9

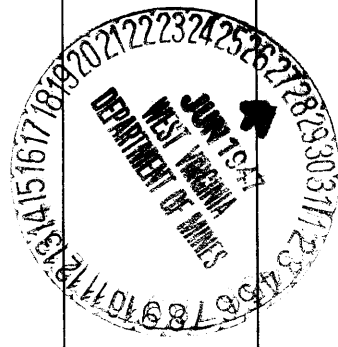

60 20 1947

Formation	Color	Hard or Soft	Top	Bottom	Oil, Gas or Water	Depth Found	Remarks

Date June 24, 1947

APPROVED Dinsmoor & Company, Owner

By Leonard Stuebel
(Title) Asst. Secy.

