


Latitude 34° 25'

Longitude 80° 55'

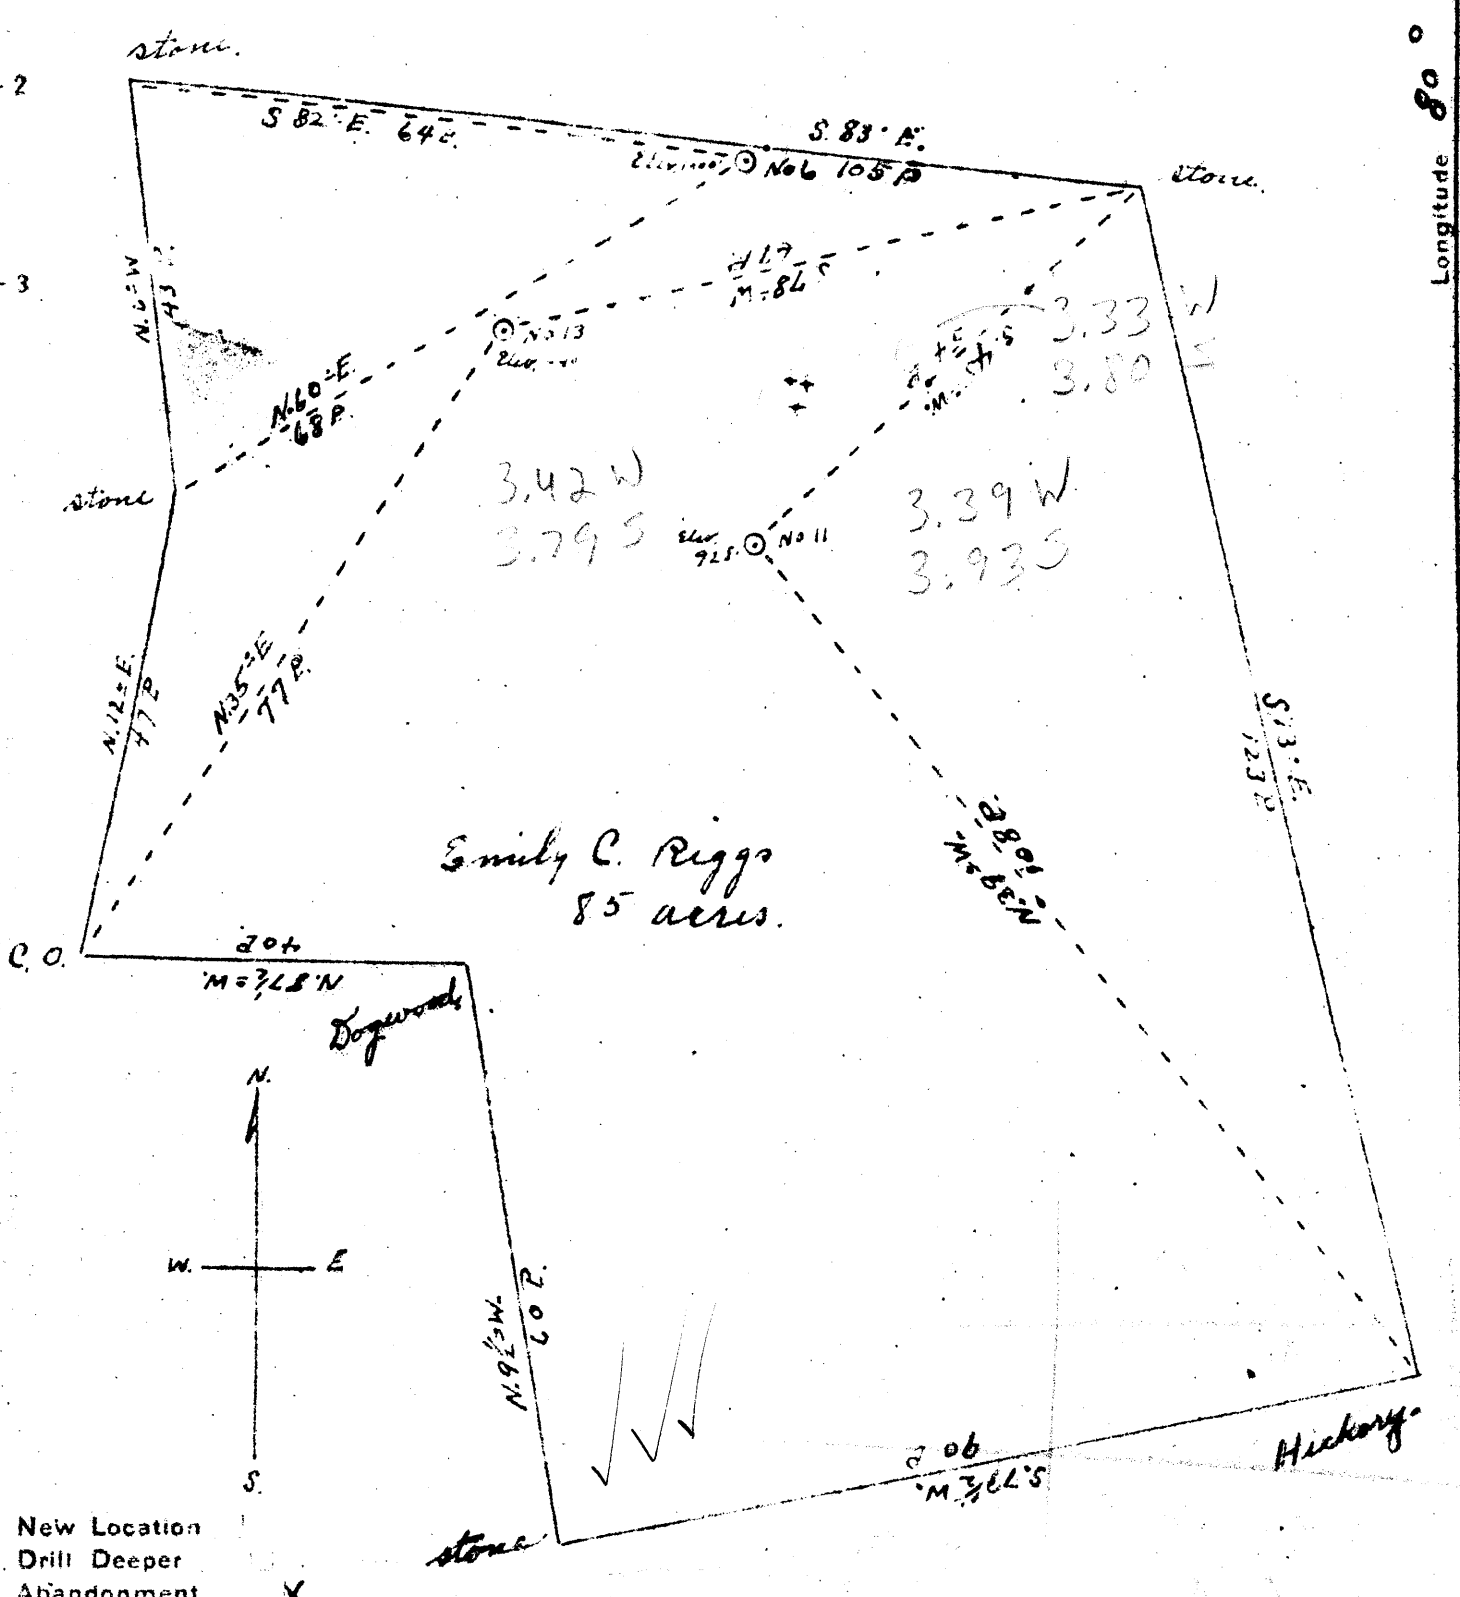

New Location
Drill Deeper
Abandonment X

Company Dinsmar & Co.
 Address St. Marys W.Va.
 Farm Emily C. Riggs
 Tract _____ Acres 85 Lease No. _____
 Well (Farm) No. 6, 11 & 13 Serial No. _____
 Elevation (Spirit Level) No. 6, 1000' No. 9, 25', No. 3, 240'
 Quadrangle West Union
 County Jasper District Meade
 Engineer Jno Triplett
 Engineer's Registration No. _____
 File No. _____ Drawing No. _____
 Date June 30 1917 Scale 1" = 20 P

STATE OF WEST VIRGINIA
 DEPARTMENT OF MINES
 OIL AND GAS DIVISION
 CHARLESTON

WELL LOCATION MAP
 FILE NO. JYL-459-A-#6
JYL-460-A-#11
JYL-461-A-#13
 + Denotes location of well on United States
 Topographic Maps, scale 1 to 62,500, lat-
 itude and longitude lines being represented
 by dotted lines as shown

- Denotes one inch square of original tracing

JYL-459-460-461A



STATE OF WEST VIRGINIA
DEPARTMENT OF MINES
OIL AND GAS DIVISION

418

WELL RECORD

Oil or Gas Well (KIND)


Permit No. 44-459-A

Company Dinsmoor & Company
 Address St. Marys, W. Va.
 Farm Emily C. Higgs Acres 85
 Location (waters) _____
 Well No. 6 Elev. 1000
 District Maade County Tyler
 The surface of tract is owned in fee by _____
 Address _____
 Mineral rights are owned by _____
 Address _____
 Drilling commenced _____
 Drilling completed 1899
 Date Shot _____ From _____ To _____
 With _____
 Open Flow _____ /10ths Water in _____ Inch
 _____ /10ths Merc. in _____ Inch
 Volume _____ Cu. Ft.
 Rock Pressure _____ lbs. _____ hrs.
 Oil _____ bbls., 1st 24 hrs.
 Fresh water _____ feet _____ feet
 Salt water _____ feet _____ feet

Casing and Tubing	Used in Drilling	Left in Well	Packers
Size			Kind of Packer
16			
13			Size of
10			
8 1/4			Depth set
6 1/2 6 1/4		1156	
5 3/16			Perf. top
3			Perf. bottom
2			Perf. top
Liners Used			Perf. bottom

CASING CEMENTED _____ SIZE _____ No. Ft. _____ Date _____
 COAL WAS ENCOUNTERED AT _____ FEET _____ INCHES
 _____ FEET _____ INCHES FEET _____ INCHES
 _____ FEET _____ INCHES FEET _____ INCHES

Formation	Color	Hard or Soft	Top	Bottom	Oil, Gas or Water	Depth Found	Remarks
Pay				1170			
Total Depth				1201			

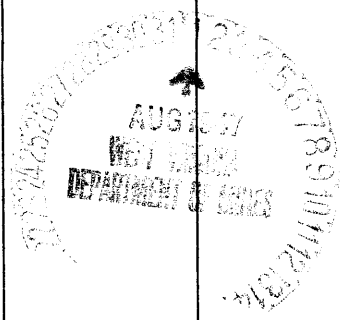

Formation	Color	Hard or Soft	Top	Bottom	Oil, Gas or Water	Depth Found	Remarks

Date July 30, 19 47

APPROVED DINSMOOR & COMPANY, Owner

By Donald Stuck Asst. Secy.
(Title)



WILLY C. BIGGS NO. 6 WELL.

Woods District, Tyler County, W. Va.

By Dinwiddie & Co., St. Marys, W. Va.

Abandoned under permit Tyl-.....-A?

On 85 acres.

Elevation, 1000' L.

Drilling completed in 1899.

6" casing, 1156'.

Oil well. Abandonment reported to Dept. of Mines July 30, 1947.

Record to RCT from Mrs. Griffith Nov. 26, 1947. Old File No. 418.

Pay
Total depth

Top. Bottom.
1174 -
1201