

New Location
 Drill Deeper
 Abandonment

DEC 16 1947

# 9	3,222 W 2,170 S
# 10	3,111 W 2,115 S
# 6	3,110 W 2,227 S
# 13	2,988 W 2,225 S

Company E.S. Woodyard
 Address Pennsboro, W. Va.
 Farm J.L. Poe
 Tract _____ Acres 150 Lease No. _____
 Well (Farm) No. 6-9-10-13 Serial No. _____
 Elevation (Spirit Level) 945-1119-949-1023
 Quadrangle West Union W.C.
 County Tyler District Meade
 Engineer A. K. Westfall
 Engineer's Registration No. _____
 File No. _____ Drawing No. _____
 Date Sept. 29, 1947 Scale 1" = 40 Poles

STATE OF WEST VIRGINIA
 DEPARTMENT OF MINES
 OIL AND GAS DIVISION
 CHARLESTON

WELL LOCATION MAP

FILE NO. JYL-467-A-#13
JYL-468-A-#6
JYL-469-A-#9
JYL-473-A-#10

+ Denotes location of well on United States Topographic Maps, scale 1 to 62,500, latitude and longitude lines being represented by border lines as shown.

- Denotes one inch spaces on border line of original tracing.



STATE OF WEST VIRGINIA
DEPARTMENT OF MINES
OIL AND GAS DIVISION

720

WELL RECORD

Oil or Gas Well Oil
(KIND)


Permit No. 107-A

Company E.S. Woodyard
 Address Pennsboro, W. Va.
 Farm J.L. Poe Acres 150
 Location (waters) _____
 Well No. 9 Elev. 1119
 District Meade County Tyler
 The surface of tract is owned in fee by Unknown
 Address _____
 Mineral rights are owned by South Penn Nat. Gas Co.
 Address Parkersburg, W. Va.
 Drilling commenced Unknown
 Drilling completed Unknown
 Date Shot Unknown From _____ To _____
 With _____
 Open Flow _____ /10ths Water in _____ Inch
 _____ /10ths Merc. in _____ Inch
 Volume _____ Cu. Ft.
 Rock Pressure _____ lbs. _____ hrs.
 Oil Unknown bbls., 1st 24 hrs.
 Fresh water None feet _____ feet
 Salt water None feet _____ feet

Casing and Tubing	Used in Drilling	Left in Well	Packers
Size			Kind of Packer
16			
13			
10	700	700	Size of
8 1/4			
6 3/4	1224	1224	Depth set
V 5 3/16			
3			Perf. top
2	1200	1200	Perf. bottom
Liners Used			Perf. top
			Perf. bottom

CASING CEMENTED _____ SIZE _____ No. Ft. _____ Date _____
 COAL WAS ENCOUNTERED AT _____ FEET _____ INCHES
 _____ FEET _____ INCHES FEET _____ INCHES
 _____ FEET _____ INCHES FEET _____ INCHES

Formation	Color	Hard or Soft	Top	Bottom	Oil, Gas or Water	Depth Found	Remarks
Pittsburgh coal			660	663			
Red Rock Cave			900	1200			
East Cow Run			1224	1254			
Gas			1235		Gas	1235	
Oil			1235		Oil	1235	

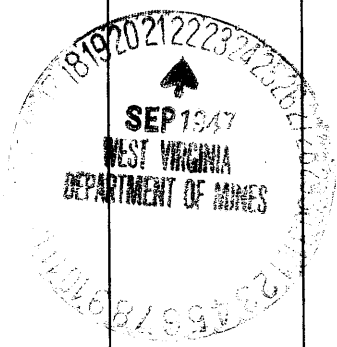

Formation	Color	Hard or Soft	Top	Bottom	Oil, Gas or Water	Depth Found	Remarks

Date Sept 20, 1947
APPROVED [Signature], Owner
By [Signature]
(Title)



J. L. POE NO. 9 WELL.

Not located.

Meade District, Tyler County, W. Va.
Carter Oil Co.
2 mi. S. of Wick.

7

	Top.	Bottom.
Coal (Uniontown?)	660	663
Cave	900	
Cow Run Sand, to bottom	1224	1254