


Latitude 39° 30'

Longitude 80° 45'

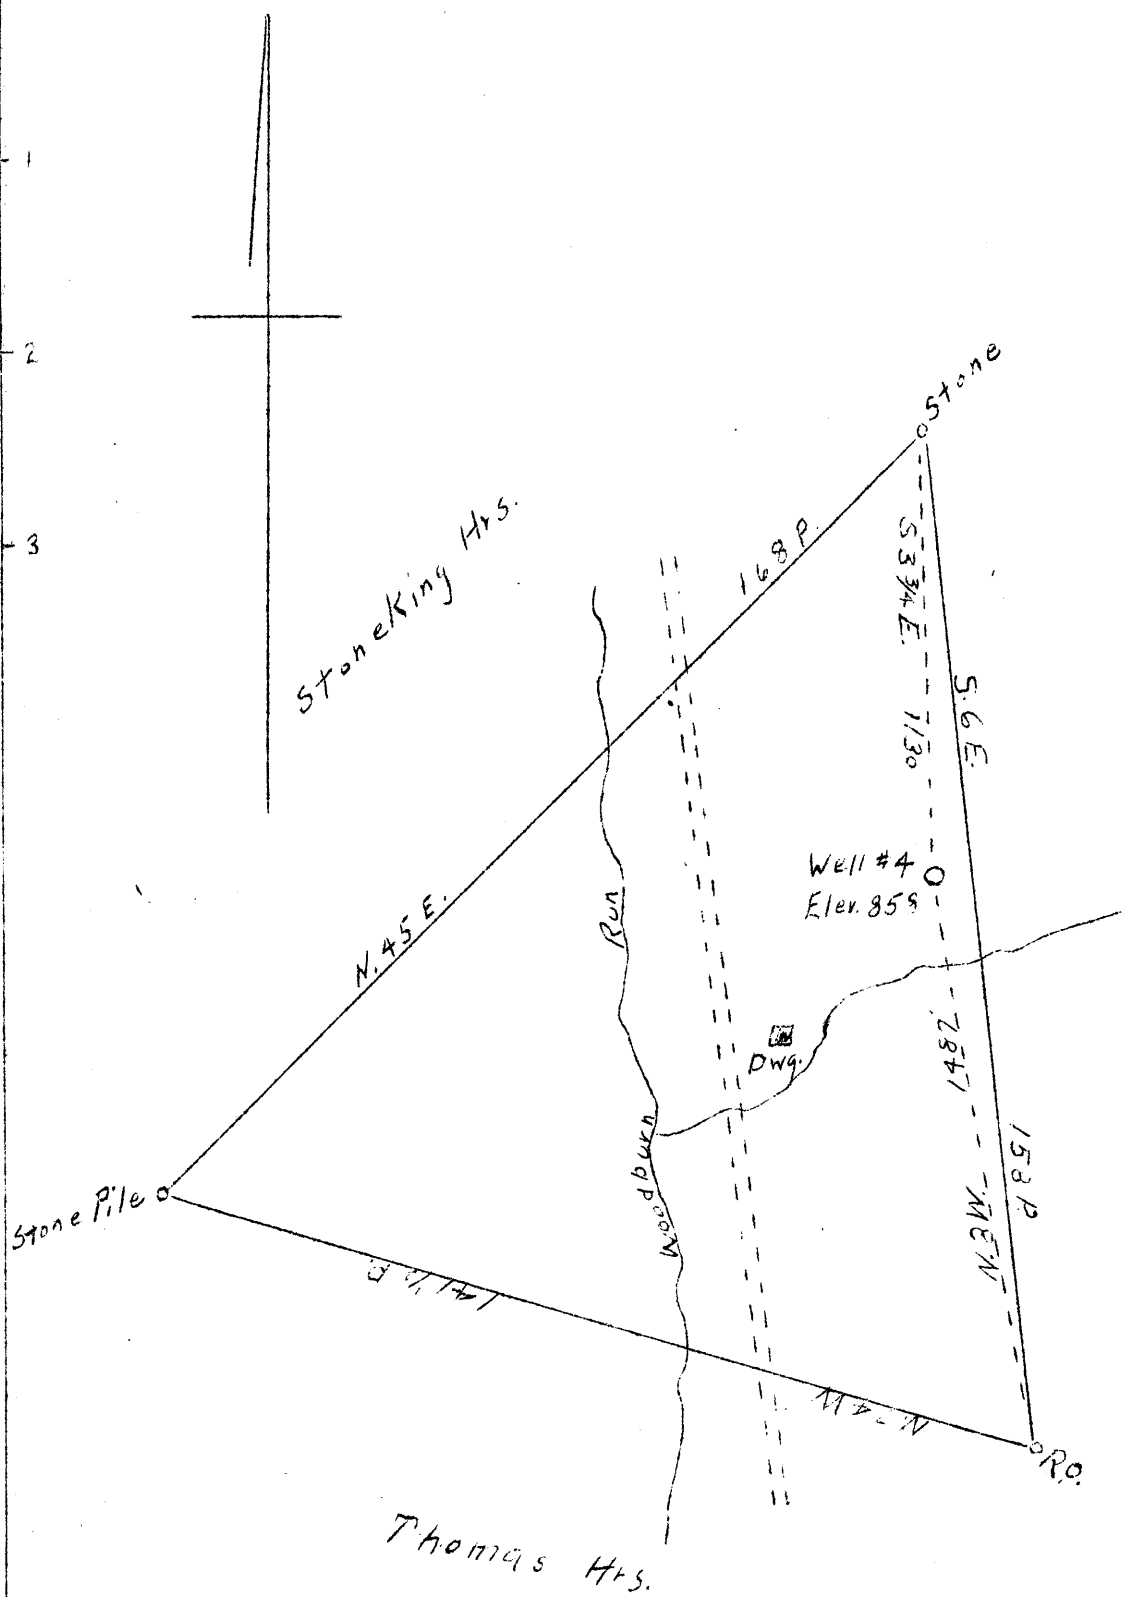

0.32 W
2.06 S

K 1/2 Hrs.

NEW LOCATION
DRILL DEEPER
ABANDONMENT X

COMPANY HIRAM UNDERWOOD, JR.
 ADDRESS SHIRLEY, W. VA.
 FARM J. A. TENNANT
 TRACT ACRES 65 LEASE NO. _____
 WELL (FARM) NO. 4 SERIAL NO. _____
 ELEVATION (SPIRIT LEVEL) 858
 QUADRANGLE WEST UNION
 COUNTY TYLER DISTRICT MCELROY
 ENGINEER A. K. WESTFALL
 ENGINEER'S REGISTRATION NO. _____
 FILE NO. _____ DRAWING NO. _____
 DATE NOV. 10, 1947 SCALE 1" = 30 FEET

STATE OF WEST VIRGINIA
 DEPARTMENT OF MINES
 OIL AND GAS DIVISION
 CHARLESTON
 WELL LOCATION MAP
 FILE NO. TYL-474-A

+ DENOTES LOCATION OF WELL ON UNITED STATES TOPOGRAPHIC MAPS, SCALE 1 TO 62,500, LATITUDE AND LONGITUDE LINES BEING REPRESENTED BY BORDER LINES AS SHOWN.
 - DENOTES ONE INCH SPACES ON BORDER LINE OF ORIGINAL TRACING.