

APR 26 1948

(Note - Elevations ran by Hope Construction & Refining Co. Engineers.)

New Location

Drill Deeper

Abandonment

Company Frank Lando

Address Box 356 Bellair, Ohio

Farm N. Salisbury

Tract 1 Acres 240 Lease No. 8-8-11-12-10

Well (Farm) No. 14-2-9-23 Serial No. (87)

Elevation (Spirit Level) 3-838' 9-988' 10-879' 11-1042' 12-1049' 14-1041' 15-885'

Co. adrange New Martinsville

County Tyler District Lincoln

Surveyor Don L. Riggle

Surveyor's Registration No. 026-1 Drawing No. Aug. 647, 47 Scale 1" = 60 ft

STATE OF WEST VIRGINIA
DEPARTMENT OF MINES
OIL AND GAS DIVISION

JYL-478-A-#8 CHARLESTON JYL-480-A-#10

JYL-479-A-#9 JYL-481-A-#11

WELL LOCATION MAP

JYL-482-A-#12

FILE NO. JYL-483-A-#14

JYL-440-A-#1 JYL-484-A-#23

JYL-441-A-#3

+ Denotes location of well on United States Topographic Maps, scale 1 to 62,500, latitude and longitude lines being represented by border lines as shown.

- Denotes one inch spaces on border line of original tracing.



STATE OF WEST VIRGINIA
DEPARTMENT OF MINES
OIL AND GAS DIVISION

457

WELL RECORD

Oil or Gas Well Oil
(KIND)


Permit No. 480 A

Company Frank Lando
Address Box 356 - Bellaire, Ohio
Farm N. Salisbury Acres 240
Location (waters) Slaughter House Run
Well No. 10 Ten Elev. 879'
District Lincoln County Tyler
The surface of tract is owned in fee by N. Salisbury
Heirs Address Sistersville
Mineral rights are owned by Mrs. Mazie Manning and
Ira Salisbury Address Sistersville
Drilling commenced Apr. 29, 1893
Drilling completed May 22, 1893
Date Shot 4/23/00 From 1667 To 1677
With 20 Quarts
Open Flow /10ths Water in _____ Inch
/10ths Merc. in _____ Inch
Volume _____ Cu. Ft.
Rock Pressure _____ lbs. _____ hrs.
Oil 40 bbls., 1st 24 hrs.
Fresh water _____ feet _____ feet
Salt water _____ feet _____ feet

Casing and Tubing	Used in Drilling	Left in Well	Packers
Size			
16			Kind of Packer
13			<u>Larkin</u>
10			Size of
8 1/4			<u>6 1/2" x 4-7/8"</u>
6 1/2"	<u>1315'</u>	<u>1315'</u>	Depth set
4-7/8"	<u>1618'</u>	<u>1618'</u>	<u>1618'</u>
3 Tbg.		<u>1701'</u>	Perf. top
2			Perf. bottom
Liners Used			Perf. top
			Perf. bottom

CASING CEMENTED _____ SIZE _____ No. Ft. _____ Date _____
COAL WAS ENCOUNTERED AT _____ FEET _____ INCHES
_____ FEET _____ INCHES FEET _____ INCHES
_____ FEET _____ INCHES FEET _____ INCHES

Formation	Color	Hard or Soft	Top	Bottom	Oil, Gas or Water	Depth Found	Remarks
First Salt			1200'	1218'			
Big Lime			1580'	1620'			
Injun			1663'	1712'			
Oil			1663'	1677'			
Total Depth				1716'			

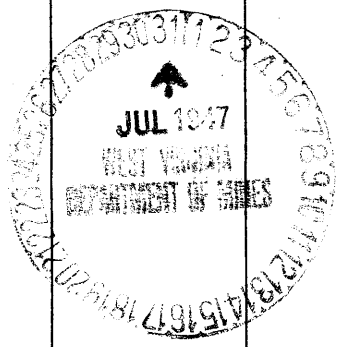

Formation	Color	Hard or Soft	Top	Bottom	Oil, Gas or Water	Depth Found	Remarks

Date _____, 19____

APPROVED Frank Ando, Owner

By _____ (Title)

