

Company Frank Lando  
 Address Box 356 Bellair, Ohio  
 Farm N. Salisbury  
 Tract 1 Acres 240 Lease No. \_\_\_\_\_  
 Well (Farm) No. 14-2-9-23 Serial No. 192  
 Elevation (Spirit Level) 8-838' 9-888' 10-879'  
12-1049' 14-1041' 15-885'  
 Quadrangle New Martinsville  
 County Tyler District Lincoln  
 Recorder Don L. Figgie  
 Recorder's Registration No. \_\_\_\_\_  
 No. 046-1 Drawing No. \_\_\_\_\_  
 Reg. 647, 47 Scale 1" = 60'

STATE OF WEST VIRGINIA  
 DEPARTMENT OF MINES  
 OIL AND GAS DIVISION  
 JYL-478-A-#8 CHARLESTON JYL-480-A-#10  
 JYL-479-A-#9 JYL-481-A-#11  
**WELL LOCATION MAP**  
 FILE NO. JYL-482-A-#12  
 JYL-440-A-#1 JYL-483-A-#14  
 JYL-441-A-#3 JYL-484-A-#23  
 + Denotes location of well on United States  
 Topographic Maps, scale 1 to 62,500; lat-  
 itude and longitude lines being represented  
 by border lines as shown.  
 - Denotes one inch spaces on border line  
 of original tracing.



453

STATE OF WEST VIRGINIA  
DEPARTMENT OF MINES  
OIL AND GAS DIVISION

WELL RECORD

Permit No. AT 483 A


Oil or Gas Well Oil  
(KIND)

Company Frank Lando  
 Address Box 356 - Bellaire, Ohio  
 Farm N. Salisbury Acres 240  
 Location (waters) Slaughter House Run  
 Well No. 14 Fourteen Elev. 1041'  
 District Lincoln County Tyler  
 The surface of tract is owned in fee by N. Salisbury  
Heirs Address Sistersville  
 Mineral rights are owned by Mrs. Mazie Manning and  
Ira Salisbury Address Sistersville  
 Drilling commenced July 17, 1893  
 Drilling completed August 27, 1893  
 Date Shot 1/30/97 From 1832 To 1842  
 With 10 Quarts  
 Open Flow /10ths Water in \_\_\_\_\_ Inch  
 /10ths Merc. in \_\_\_\_\_ Inch  
 Volume \_\_\_\_\_ Cu. Ft.  
 Rock Pressure \_\_\_\_\_ lbs. \_\_\_\_\_ hrs.  
 Oil 85 bbls., 1st 24 hrs.  
 Fresh water \_\_\_\_\_ feet \_\_\_\_\_ feet  
 Salt water \_\_\_\_\_ feet \_\_\_\_\_ feet

Casing and Tubing	Used in Drilling	Left in Well	Packers
Size			Kind of Packer
16			<b>Larkin</b>
13			Size of
10			<b>6 1/2" x 4-7/8"</b>
8 1/4			Depth set
6 1/2"	<b>1180'</b>	<b>1180'</b>	<b>1727'</b>
4-7/8"	<b>1727'</b>	<b>1727'</b>	
3			Perf. top
2 Tbg.		<b>1877'</b>	Perf. bottom
Liners Used			Perf. top
			Perf. bottom

CASING CEMENTED \_\_\_\_\_ SIZE \_\_\_\_\_ No. Ft. \_\_\_\_\_ Date \_\_\_\_\_  
 COAL WAS ENCOUNTERED AT \_\_\_\_\_ FEET \_\_\_\_\_ INCHES  
 \_\_\_\_\_ FEET \_\_\_\_\_ INCHES FEET \_\_\_\_\_ INCHES  
 \_\_\_\_\_ FEET \_\_\_\_\_ INCHES FEET \_\_\_\_\_ INCHES

Formation	Color	Hard or Soft	Top	Bottom	Oil, Gas or Water	Depth Found	Remarks
<b>First Salt</b>			<b>1275'</b>				
<b>Big Lime</b>			<b>1700'</b>	<b>1760'</b>			
<b>Big Injun</b>			<b>1828'</b>				
<b>Oil</b>			<b>1828'</b>				
<b>Total Depth</b>				<b>1887'</b>			

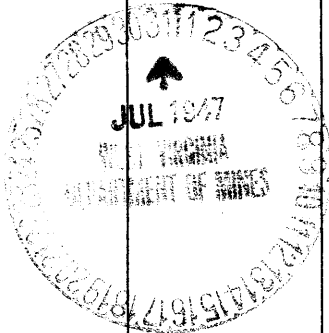

SEP 20 1911

