


Latitude 7° 35'

Longitude 80° 50'

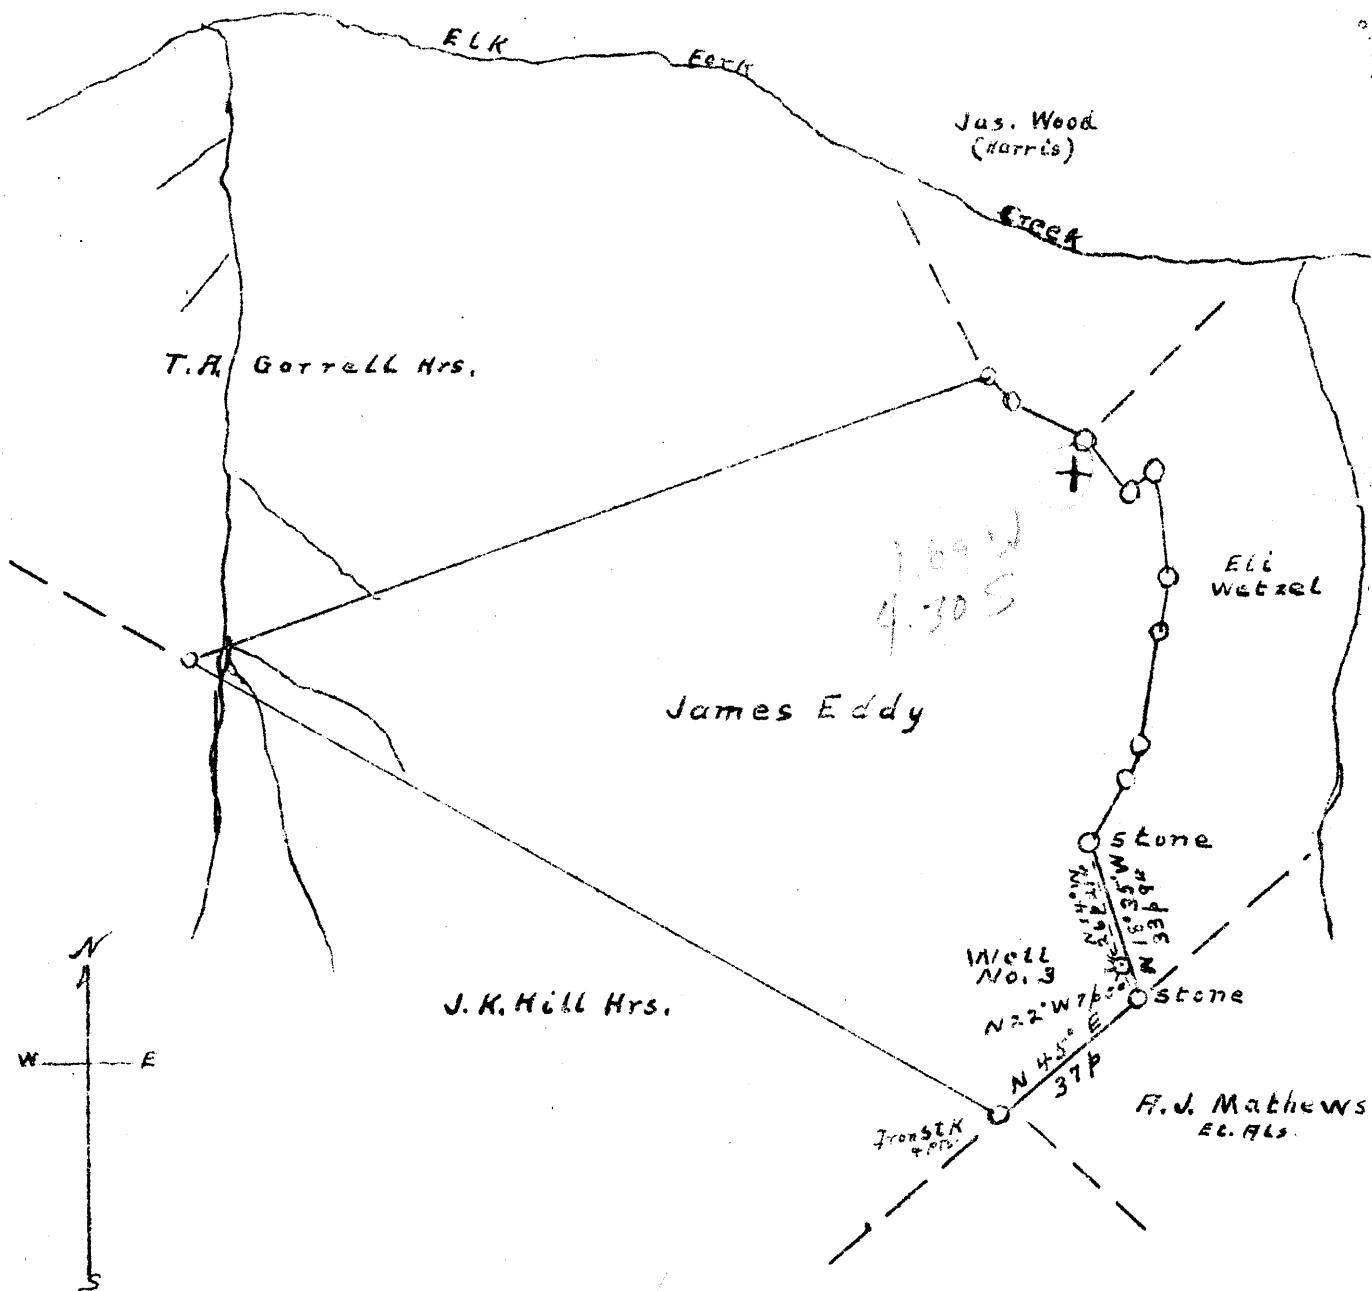

New Location
 Drill Deeper
 Abandonment

Company J.R. Bull
 Address Sistersville, W.Va.
 Farm James Eddy
 Tract 1 Acres 83 Lease No. 81320
 Well (Farm) No. 3 Serial No. _____
 Elevation (Spirit Level) 1154'
 Quadrangle New Martinsville
 County Tyler District Ellsworth
 Engineer Don L. Riggle
 Engineer's Registration No. _____
 File No. 046-S.P.11 Drawing No. 137B
 Date Apr. 16, 48 Scale 1" = 40 rods

STATE OF WEST VIRGINIA
 DEPARTMENT OF MINES
 OIL AND GAS DIVISION
 CHARLESTON

WELL LOCATION MAP
 FILE NO. JYL-492-A

+ Denotes location of well on United States Topographic Maps, scale 1 to 62,500, latitude and longitude lines being represented by border lines as shown.

- Denotes one inch spaces on border line of original tracing.