

New Location   
 Drill Deeper   
 Abandonment

Company All-Penn Oil & Gas Co.  
 Address 311 Ross St. Pittsburgh Pa  
 Farm J.W. Booher  
 Tract 1 Acres 58 Lease No. 42644  
 Well (Farm) No. 1 Serial No. 7133  
 Elevation (Spirit Level) 1006'  
 Quadrangle West Union  
 County Tyler District McElroy  
 Engineer A.L. Headley  
 Engineer's Registration No. \_\_\_\_\_  
 File No. \_\_\_\_\_ Drawing No. \_\_\_\_\_  
 Date 8-28-1947 Scale 1 inch = 500'

STATE OF WEST VIRGINIA  
 DEPARTMENT OF MINES  
 OIL AND GAS DIVISION  
 CHARLESTON

WELL LOCATION MAP  
 FILE NO. JYL-496-A

+ Denotes location of well on United States Topographic Maps, scale 1 to 62,500. latitude and longitude lines being represented by border lines as shown.  
 - Denotes one inch spaces on border line of original tracing.



STATE OF WEST VIRGINIA  
DEPARTMENT OF MINES  
OIL AND GAS DIVISION

WELL RECORD

Permit No. \_\_\_\_\_

Oil or Gas Well Gas  
(KIND)


Company All-Penn Oil & Gas Co.  
Address A. M. Snyder, Hundred, W. Va.  
Farm J. W. Booher Acres 58  
Location (waters) Branch of Indian Creek  
Well No. 1 Elev. 1006  
District McElroy County Tyler  
The surface of tract is owned in fee by \_\_\_\_\_  
Address \_\_\_\_\_  
Mineral rights are owned by \_\_\_\_\_  
Address \_\_\_\_\_  
Drilling commenced May, 25, 1920  
Drilling completed Oct. 7, 1920  
Date Shot \_\_\_\_\_ From \_\_\_\_\_ To \_\_\_\_\_  
With \_\_\_\_\_  
Open Flow \_\_\_\_\_ /10ths Water in No Record Inch  
\_\_\_\_\_ /10ths Merc. in \_\_\_\_\_ Inch  
Volume 465,000 Cu. Ft.  
Rock Pressure No Record lbs. \_\_\_\_\_ hrs.  
Oil \_\_\_\_\_ bbls., 1st 24 hrs.  
Fresh water \_\_\_\_\_ feet \_\_\_\_\_ feet  
Salt water \_\_\_\_\_ feet \_\_\_\_\_ feet

Casing and Tubing	Used in Drilling	Left in Well	Packers
Size			Kind of Packer
16			
13			
10	<u>367</u>	<u>307 Pulled</u>	Size of _____
8 1/4	<u>1086</u>	<u>Pulled</u>	Depth set _____
6%	<u>1906</u>	<u>1906</u>	Perf. top _____
5 3/16	<u>2797</u>	<u>2797</u>	Perf. bottom _____
3			Perf. top _____
2	<u>2787</u>	<u>2787</u>	Perf. bottom _____
Liners Used			Perf. top _____
			Perf. bottom _____

CASING CEMENTED \_\_\_\_\_ SIZE \_\_\_\_\_ No. Ft. \_\_\_\_\_ Date \_\_\_\_\_

COAL WAS ENCOUNTERED AT 681 FEET 36 INCHES  
\_\_\_\_\_ FEET \_\_\_\_\_ INCHES FEET \_\_\_\_\_ INCHES  
\_\_\_\_\_ FEET \_\_\_\_\_ INCHES FEET \_\_\_\_\_ INCHES

Formation	Color	Hard or Soft	Top	Bottom	Oil, Gas or Water	Depth Found	Remarks
Pittsburgh	Coal		681	684			
Cow Run			1140	1170			
Salt Sand (upper)			1316	1356			
Salt Sand (middle)			1413	1612			
Maxon			1753	1773			
Little Lime			1876	1894			
Pencil Cave			1894	1904			
Big Lime			1904	1977			
Big Injun Sand			1982	2195	Gas	2048	
Fifty Foot Sand			2422				
Gordon Stray			2746	2780			
Total Depth				2797	Gas Gas	2757 2769	

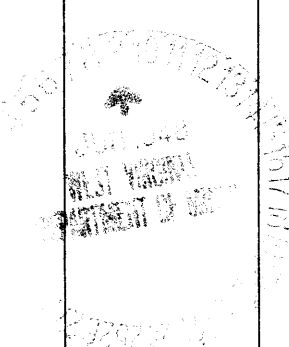

Formation	Color	Hard or Soft	Top	Bottom	Oil, Gas or Water	Depth Found	Remarks

Date \_\_\_\_\_, 19\_\_\_\_

APPROVED \_\_\_\_\_, Owner

By \_\_\_\_\_ (Title)

