


# 4	0.61 S	3.37 W
# 3	0.67 S	3.74 W
# 6	0.69 S	3.40 W
# 2	0.68 S	3.11 W

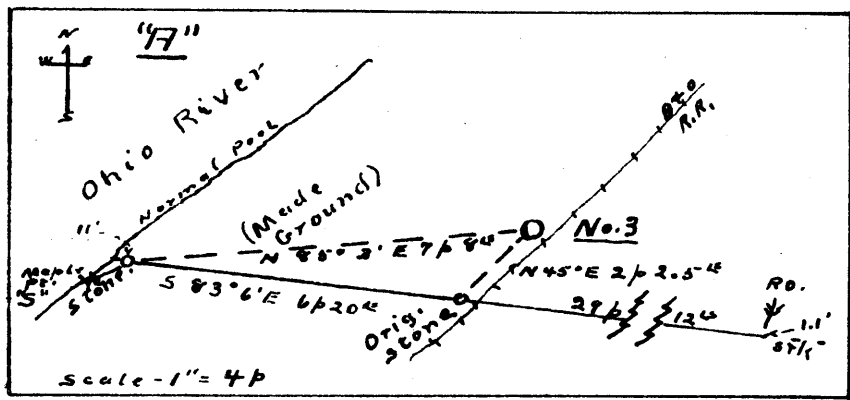

New Location
 Drill Deeper
 Abandonment

Casing heads:-
 No. 3 + 6.2' No. 6 + 1.5'
 No. 4 + 1' No. 12 + 3'

(No. 3 Well has previously been located on 1924 Topo. Sheet.)

Company Roy W. Confer Co.
 Address 515 Allen St. Titusville, Pa.
 Farm E. P. Russell
 Tract 1 Acres 60 Lease No. _____
 Well (Farm) No. 3, 4, 6 & 12 Serial No. _____
 Elevation (Spirit Level) 4-1062.506/12-900.031'
 Quadrangle New Martinsville
 County Tyler District Lincoln
 Engineer Don L. Riggle **SW**
 Engineer's Registration No. _____
 File No. 046-SP. 11 Drawing No. _____
 Date Apr. 28, 48 Scale 1" = 60'

STATE OF WEST VIRGINIA
 DEPARTMENT OF MINES
 OIL AND GAS DIVISION
 CHARLESTON

WELL LOCATION MAP

FILE NO. JYL-542-A-#4
JYL-545-A-#12 JYL-543-A-#3
JYL-544-A-#6

+ Denotes location of well on United States Topographic Maps, scale 1 to 62,500, latitude and longitude lines being represented by border lines as shown.

- Denotes one inch spaces on border line of original tracing.



STATE OF WEST VIRGINIA
DEPARTMENT OF MINES
OIL AND GAS DIVISION

479

Permit No. 548-A

WELL RECORD


Oil or Gas Well Oil
(KIND)

Company Roy W. Confer Co.
Address 515 Allen Street, Titusville, Pa.
Farm E. P. Russell Acres 60
Location (waters) _____
Well No. 4 Elev. 1062.506
District Linsela County Tyler
The surface of tract is owned in fee by E. P. Russell
Address Sistersville, WVa
Mineral rights are owned by South Penn Oil Co
Address Parkersburg, WVa
Drilling commenced _____
Drilling completed _____
Date Shot No Record from _____ To _____
With _____
Open Flow _____ /10ths Water in _____ Inch
_____ /10ths Merc. in _____ Inch
Volume _____ Cu. Ft.
Rock Pressure _____ lbs. _____ hrs.
Oil No Record bbls., 1st 24 hrs.
Fresh water _____ feet _____ feet
Salt water _____ feet _____ feet

Casing and Tubing	Used in Drilling	Left in Well	Packers
Size			Kind of Packer
16			
13			
10	<u>40'</u>	<u>Pulled Out</u>	of
	<u>400'</u>		
<u>6 3/4</u>	<u>1050'</u>		Depth set
<u>5 3/16</u>			
<u>3 1/2</u>	<u>1745'</u>		Perf. top
<u>2</u>			Perf. bottom
Liners Used			Perf. top
			Perf. bottom

CASING CEMENTED _____ SIZE _____ No. Ft. _____ Date _____
COAL WAS ENCOUNTERED AT _____ FEET _____ INCHES
_____ FEET _____ INCHES FEET _____ INCHES
_____ FEET _____ INCHES FEET _____ INCHES

Formation	Color	Hard or Soft	Top	Bottom	Oil, Gas or Water	Depth Found	Remarks
<u>Big Injun</u>			<u>1772'</u>	<u>1844'</u>	<u>Oil</u>	<u>1772'</u>	

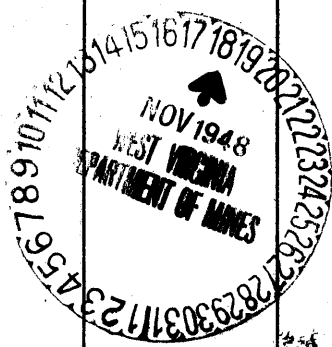

E. P. RUSSELL NO. 4 WELL.

540A

Lincoln District, Tyler County, W. Va.

By Roy W. Confer Co., 515 Allen St., Titusville, Pa.

Abandoned under permit Tyl-.....-A?

On 60 acres.

Elevation, 1062.506' L.

Surface owned by E. P. Russell, Sistersville, W. Va., and minerals
by South Penn Oil Co., Parkersburg, W. Va.

Date shot, no record.

Date of completion, etc., not given.

10" casing, 40' (pulled); 8 $\frac{1}{4}$ " , 400' (pulled); 6 $\frac{1}{4}$ " , 1050'; 4-7/8" , 1745'.

Oil well. Record to Dept. of Mines stamped Nov. 18, 1948.

Record to RCT from Mrs. Griffith Feb. 17, 1949. Old File No. 479.

	Top.	Bottom.
Big Injun Sand (oil, 1772')	1772	- 1844
Total depth		1844