


| | | |
|---|------|---|
| 4 | 0.61 | S |
| | 3.37 | W |
| 3 | 0.67 | S |
| | 3.74 | W |
| 6 | 0.69 | S |
| | 3.40 | W |
| 2 | 0.68 | S |
| | 3.11 | W |

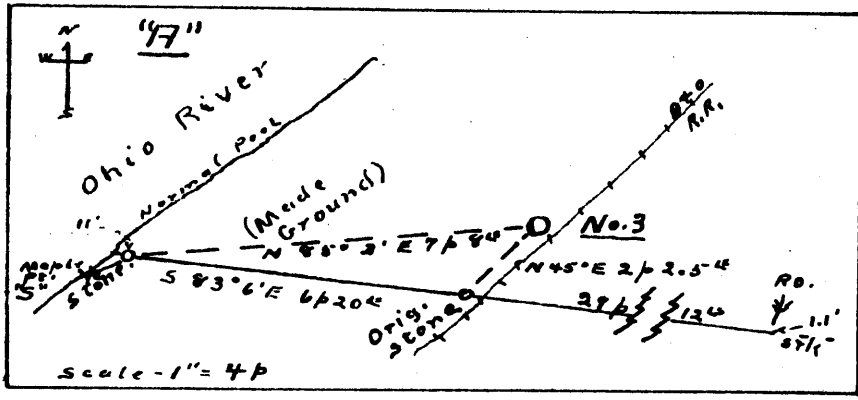

New Location
 Drill Deeper
 Abandonment

Casing heads:-
 No. 3 + 0.2' No. 6 + 1.5'
 No. 4 + 1' No. 12 + 3'
 (No. 3 Well has previously been located on 1924 Topo. Sheet.)

Company Roy W. Confer Co.
 Address 515 Allen St. Titusville, Pa.
 Farm E. P. Russell
 Tract 1 Acres 60 Lease No. _____
 Well (Farm) No. 3, 4, 6 & 12 Serial No. 3-529,021/6-1029,836
 Elevation (Spirit Level) 4-1062.506/12-900.031
 Quadrangle New Martinsville
 County Tyler District Lincoln
 Engineer Don L. Riggle
 Engineer's Registration No. _____
 File No. 046-S.P. 11 Drawing No. _____
 Date Apr. 28, 48 Scale 1" = 60'

STATE OF WEST VIRGINIA
 DEPARTMENT OF MINES
 OIL AND GAS DIVISION
 CHARLESTON

WELL LOCATION MAP

FILE NO. JYL-542-A-#4
JYL-545-A-#12 JYL-543-A-#3
JYL-544-A-#6

+ Denotes location of well on United States Topographic Maps, scale 1 to 62,500, latitude and longitude lines being represented by border lines as shown.

- Denotes one inch spaces on border line of original tracing.



STATE OF WEST VIRGINIA
DEPARTMENT OF MINES
OIL AND GAS DIVISION

WELL RECORD

464

AP 544A
Permit No. _____

Oil or Gas Well **011**
(KIND)

Company **Roy W. Confer Co.**
 Address **515 Allen Street, Titusville, Pa.**
 Farm **E. P. Russell** Acres **60**
 Location (waters) _____
 Well No. **6** Elev. **1028.836**
 District **Lincoln** County **Tyler**
 The surface of tract is owned in fee by **E. P. Russell**
 Address **Sistersville, WVa 8 1/4**
 Mineral rights are owned by **South Penn Oil Co.**
 Address **Parkersburg, WVa**
 Drilling commenced _____
 Drilling completed _____
 Date Shot ***See below** from _____ To _____
 With _____

| Casing and Tubing | Used in Drilling | Left in Well | Packers |
|-------------------|------------------|--------------|----------------|
| Size | | | Kind of Packer |
| 16 | | | |
| 13 | | | |
| 10 | | | Size of |
| 8 1/4 | 1260' | | Depth set |
| 5 3/16 | 1490' | | Perf. top |
| 4 | | | Perf. bottom |
| 2 | | | Perf. top |
| Liners Used | | | Perf. bottom |

Open Flow /10ths Water in _____ Inch
 /10ths Merc. in _____ Inch
 Volume _____ Cu. Ft.
 Rock Pressure _____ lbs. _____ hrs.
 Oil **No Record** bbls., 1st 24 hrs.
 Fresh water _____ feet
 Salt water _____ feet

| CASING CEMENTED | SIZE | No. Ft. | Date |
|-------------------------|------|---------|--------|
| | | | |
| COAL WAS ENCOUNTERED AT | | FEET | INCHES |
| | | FEET | INCHES |
| | | FEET | INCHES |

| Formation | Color | Hard or Soft | Top | Bottom | Oil, Gas or Water | Depth Found | Remarks |
|------------------|-------|--------------|--------------|--------------|-------------------|--------------|---------|
| Big Injun | | | 1745' | 1840' | 011 | 1745' | |
| | | | | | | | |
| | | | | | | | |
* 8/29/94 - 10 qts.
 8/2/97 v- 10 qts*
 3/12/99 - 20 qts.



E. P. RUSSELL NO. 6 WELL.

Lincoln District, Tyler County, W. Va.

By Roy W. Confer Co., 515 Allen St., Titusville, Pa.

Abandoned under permit Tyl-.....-A?

On 60 acres.

Elevation, 1028.836' L.

Surface owned by E. P. Russell, Sistersville, W. Va., and minerals by

South Penn Natural Gas Co., Parkersburg, W. Va.

Date of completion not given.

Shot Aug. 29, 1894, with 10 qts.; Aug. 2, 1897, with 10 qts., and

Mar. 12, 1899, with 20 qts.

6 1/4" casing 1260'; 4-7/8", 1490'.

Oil well. Record to Dept. of Mines stamped Nov. 18, 1948.

Record to RCT from Mrs. Griffith Jan. 22, 1949. Old File No. 464.

Big Injun Sand (oil, 1745')

Total depth

Top. Bottom.

1745 - 1840

1840

544A