


Latitude 37° 30'

Longitude 81° 00'

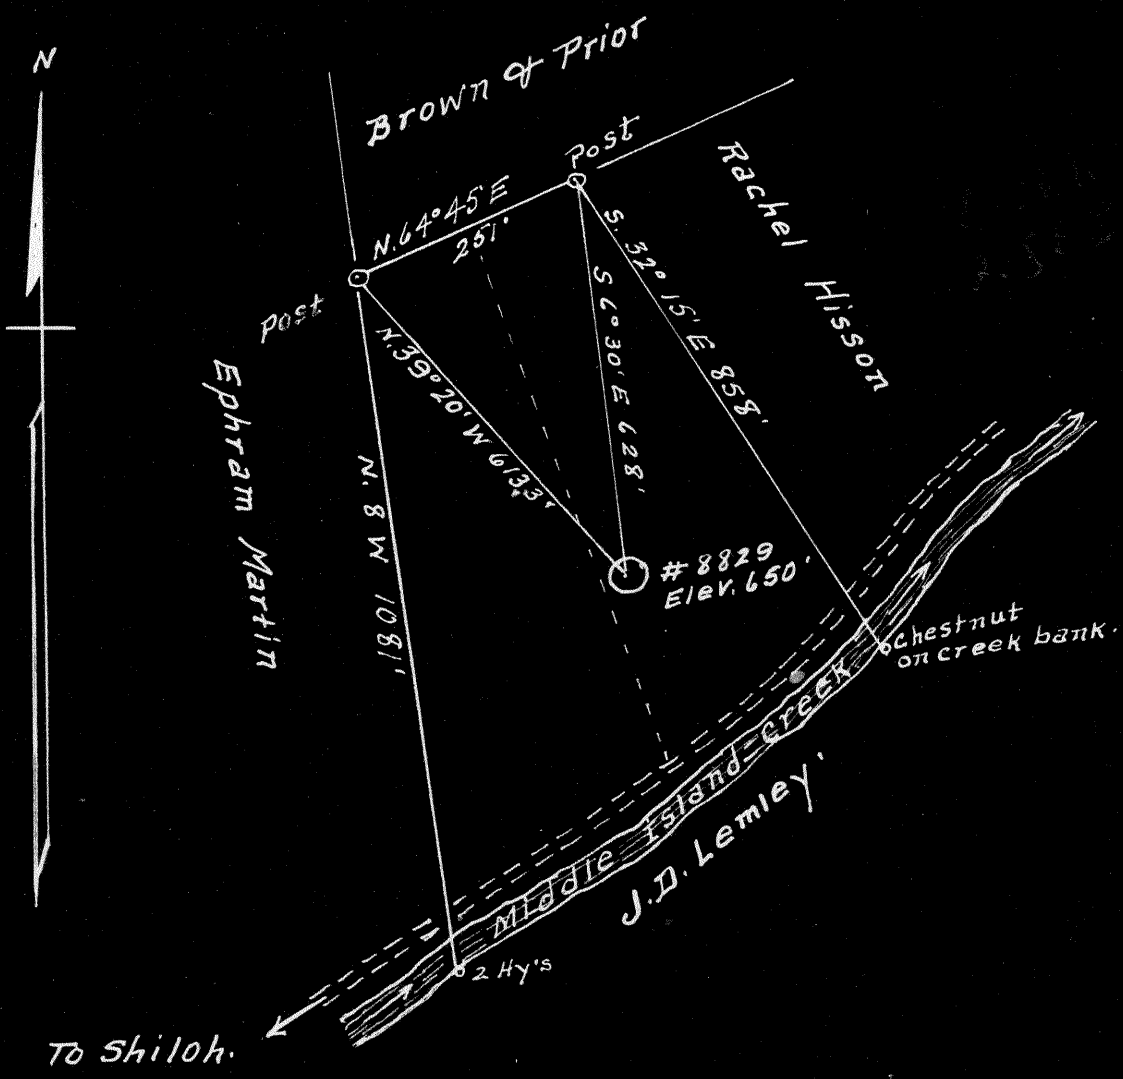

Surface & Coal = Chas. Goodrich
R.# 1, Friendly, W.Va.

2.90 SW
0.37 W

New Location...
 Drill Deeper.....
 Abandonment.....

Company Walter Conley
 Address Reader, W.Va.
 Farm Chas. Goodrich
 Tract 1 Acres 15 Lease No. 42429
 Well (Farm) No. 1 Serial No. 8829
 Elevation (Spirit Level) 650'
 Quadrangle St. Marys
 County Tyler District Union
 Engineer A. L. Headley
 Engineer's Registration No. 2021
 File No. _____ Drawing No. _____
 Date 2-24-1949 Scale 1" = 300'

STATE OF WEST VIRGINIA
 DEPARTMENT OF MINES
 OIL AND GAS DIVISION
 CHARLESTON

WELL LOCATION MAP
 FILE NO. JYL-572-A

+ Denotes location of well on United States Topographic Maps, scale 1 to 62,500, latitude and longitude lines being represented by border lines as shown.

- Denotes one inch spaces on border line of original tracing.



504

STATE OF WEST VIRGINIA
DEPARTMENT OF MINES
OIL AND GAS DIVISION

WELL RECORD

Permit No. 572-A

Oil or Gas Well X (KIND)

Company Walter Conley
Address Reader, W. Va.
Farm Chas. Goodrich Acres 15
Location (waters) Middle Island Creek
Well No. 1 Elev. 650
District Union County Tyler
The surface of tract is owned in fee by Chas. Goodrich
Friendly Address W. Va.
Mineral rights are owned by Same
Address _____

Drilling commenced No Record
Drilling completed June 1919
Date Shot No Record From _____ To _____
With _____

Open Flow _____ /10ths Water in _____ Inch
_____ /10ths Merc. in _____ Inch
Volume _____ Cu. Ft.
Rock Pressure _____ lbs. _____ hrs.
Oil _____ bbls., 1st 24 hrs.
Fresh water _____ feet _____ feet
Salt water _____ feet _____ feet

Casing and Tubing	Used in Drilling	Left in Well	Packers
Size			Kind of Packer
16			
13			
10	140	Pulled	Size of
8 1/2	810	"	
6 3/4	1216	1216	Depth set
5 3/16			
3			Perf. top
2	1550	1550	Perf. bottom
Liners Used			Perf. top
			Perf. bottom

CASING CEMENTED _____ SIZE _____ No. Ft. _____ Date _____

COAL WAS ENCOUNTERED No Coal FEET _____ INCHES _____
FEET _____ INCHES FEET _____ INCHES
FEET _____ INCHES FEET _____ INCHES

Formation	Color	Hard or Soft	Top	Bottom	Oil, Gas or Water	Depth Found	Remarks
Maxon Sand			1418	1433			
Big Lime			1443	1514			
Keener			1514	1533			
Total Depth				1550	Gas	Keener Sand	

