

#12	0.81	S
	3.81	W
#5	0.73	S
	3.48	W
#15	0.50	S
	3.79	W
#16	0.74	S
	4.11	W

Surface owned by Wm. & Laura A. Smith.  
 Address: Mr. Wm. Smith, Shirley, Tyler Co. W. Va.

No Coal ever sold under this tract, if any, it belongs to the owner of the Surface.

- New Location...
- Drill Deeper.....
- Abandonment.....

On 800' Map Sheet N47. Sqs. S 3-4 W 6-7.

Company Randall-Zogg Supply Co.  
 Address Owensboro, Ky.  
 Farm David Underwood  
 Tract \_\_\_\_\_ Acres 247 Lease No. \_\_\_\_\_  
 Well (Farm) Nos 5, 12, 15, & 16. Serial No. \_\_\_\_\_  
 Elevation (Spirit Level) See Wells above for Elev.  
 Quadrangle Centerpoint  
 County Tyler District M'Elroy  
 Engineer A. L. Headley  
 Engineer's Registration No. 2021  
 File No. \_\_\_\_\_ Drawing No. \_\_\_\_\_  
 Date Feb. 18th, 1949. Scale 1" = 800 Feet

STATE OF WEST VIRGINIA  
 DEPARTMENT OF MINES  
 OIL AND GAS DIVISION  
 CHARLESTON

**WELL LOCATION MAP**

JYL-573-A-#12  
 FILE NO. JYL-574-A-#5  
 JYL-576-A-#15  
 JYL-577-A-#16

+ Denotes location of well on United States Topographic Maps, scale 1 to 62,500, latitude and longitude lines being represented by border lines as shown.

- Denotes one inch spaces on border line of original tracing.



512

STATE OF WEST VIRGINIA  
DEPARTMENT OF MINES  
OIL AND GAS DIVISION

WELL RECORD

Permit No. 573-A

Oil or Gas Well OIL  
(KIND)

Company RANDALL-ZOGG SUPPLY COMPANY  
Address BOX 526, CHARLESTON, 22 W. VA.  
Farm David Underwood Acres 247  
Location (waters) Davis Run  
Well No. 12 Elev. 780.32  
District W. Virginia County Dyer  
The surface of tract is owned in fee by Wm. & Laura A. Smith,  
o/o Wm. Smith Address Shirley, W. Va.  
Mineral rights are owned by Wm. & Laura A. Smith,  
Address Shirley, W. Va.

Casing and Tubing	Used in Drilling	Left in Well	Packers
Size			Kind of Packer
16			
13			
10	170'		Size of
8 3/4	790'		
6 5/8	1788'	1788'	Depth set
5 3/16	1826'	1826'	
3			Perf. top
2	1923'	1923'	Perf. bottom
Liners Used			Perf. top
			Perf. bottom


Drilling commenced \_\_\_\_\_  
Drilling completed \_\_\_\_\_  
Date Shot SEE BELOW From \_\_\_\_\_ To \_\_\_\_\_  
With \_\_\_\_\_  
Open Flow \_\_\_\_\_ /10ths Water in \_\_\_\_\_ Inch  
\_\_\_\_\_ /10ths Merc. in \_\_\_\_\_ Inch  
Volume \_\_\_\_\_ Cu. Ft.  
Rock Pressure \_\_\_\_\_ lbs. \_\_\_\_\_ hrs.  
Oil \_\_\_\_\_ bbls., 1st 24 hrs.  
Fresh water \_\_\_\_\_ feet \_\_\_\_\_ feet  
Salt water \_\_\_\_\_ feet \_\_\_\_\_ feet

CASING CEMENTED \_\_\_\_\_ SIZE \_\_\_\_\_ No. Ft. \_\_\_\_\_ Date \_\_\_\_\_  
COAL WAS ENCOUNTERED AT 495 FEET \_\_\_\_\_ INCHES  
\_\_\_\_\_ FEET \_\_\_\_\_ INCHES \_\_\_\_\_ FEET \_\_\_\_\_ INCHES  
\_\_\_\_\_ FEET \_\_\_\_\_ INCHES \_\_\_\_\_ FEET \_\_\_\_\_ INCHES

Formation	Color	Hard or Soft	Top	Bottom	Oil, Gas or Water	Depth Found	Remarks
Pittsburgh Coal			495'				
Big Injun Sand			1824'		OIL	1904'	
Total Depth			1923'				

**SHOT RECORD**

DATE SHOT	NO. QTS.	TOP OF SHOT
6-22-00	20	No Record
9-18-01	30	1902'
9-1-05	40	1904'
3-21-12	60	1902'

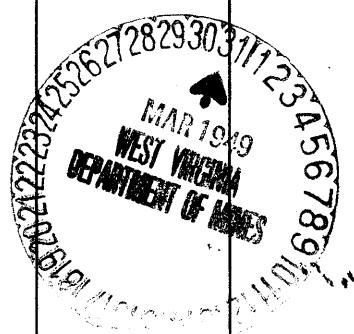

Formation	Color	Hard or Soft	Top	Bottom	Oil, Gas or Water	Depth Found	Remarks

Date March 31, 1949

APPROVED RANDALL ZOGG SUPPLY COMPANY, Owner

By *W. J. Langham*  
(Title) **Agent**