

Map Sh. 53 Sq. 51-2 W 7 FB. 665 P-37

Company Hope Natural Gas Co.
 Address Clarksburg, W. Va.
 Farm Hannah Merritt
 Tract _____ Acres 74 Lease No. 33994
 Well (Farm) No. _____ Serial No As Shown
 Elevation (Spirit Level) As Shown
 Quadrangle Centerpoint
 County Tyler District M. E. Troy
 Engineer W. M. Bowers
 Engineer's Registration No. 900
 File No. _____ Drawing No. _____
 Date 8-1-46 Scale 1" = 40P

STATE OF WEST VIRGINIA
 DEPARTMENT OF MINES
 OIL AND GAS DIVISION
 CHARLESTON

WELL LOCATION MAP
 FILE NO. TYL-462-A-NO6728
594 + 596

+ Denotes location of well on United States Topographic Maps, scale 1 to 62,500, latitude and longitude lines being represented by border lines as shown.

- Denotes one inch spaces on border line of original tracing.



STATE OF WEST VIRGINIA
DEPARTMENT OF MINES
OIL AND GAS DIVISION

536

WELL RECORD

Permit No. 5944

~~Other~~ Gas Well (KIND)


Company Hope Natural Gas Company.
Address 445 West Main St. Clarksburg, W. Va.
Farm Hannah Merritt Acres 74
Location (waters) _____
Well No. 6700 Elev. 1095
District McElroy County Tyler
The surface of tract is owned in fee by _____
Address _____
Mineral rights are owned by _____
Address _____
Drilling commenced February 27, 1925
Drilling completed April 11, 1925
Date Shot _____ From _____ To _____
With _____
Open Flow /10ths Water in _____ Inch
/10ths Merc. in _____ Inch
Volume _____ Cu. Ft.
Rock Pressure _____ lbs. _____ hrs.
Oil _____ bbls., 1st 24 hrs.
Fresh water none recorded feet _____ feet
Salt water 1278 1575 feet _____ feet

Casing and Tubing	Used in Drilling	Left in Well	Packers
Size			Kind of Packer
16			
13			
10	<u>411</u>	<u>Pulled</u>	Size of
8 1/4	<u>1247</u>	<u>Pulled</u>	Depth set
6 5/8	<u>1669</u>	<u>1669</u>	
5 3/16	<u>2014</u>	<u>2014</u>	Perf. top
3			Perf. bottom
2			Perf. top
Liners Used			Perf. bottom

CASING CEMENTED NOT SIZE _____ No. Ft. _____ Date _____

COAL WAS ENCOUNTERED AT 153 FEET 24 INCHES
708 FEET 24 INCHES 758 FEET 72 INCHES
_____ FEET _____ INCHES _____ FEET _____ INCHES

Formation	Color	Hard or Soft	Top	Bottom	Oil, Gas or Water	Depth Found	Remarks
Coal			153	155			
Coal			708	710			
Pitts. Coal			758	764			
Little Dunkard			1025	1074			
Big Dunkard			1134	1152			
Gas sand			1228	1327	water	1278	
First Salt			1378	1487			
Second Salt			1548	1590	water	1575	
Third salt			1600	1693			
Maxon			1863	1891			
Little Lime			1975	1985			
Pencil cave			1985	1990			
Big Lime			1990	2055			
Big Injun			2055	2215	gas	2080-90	show oil 2182
Squaw			2216	2235			
Total depth				2239			

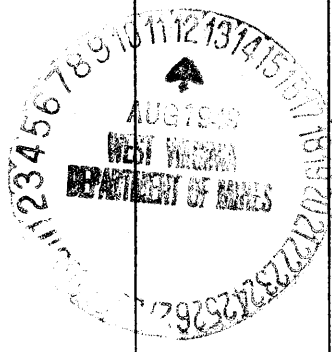

Formation	Color	Hard or Soft	Top	Bottom	Oil, Gas or Water	Depth Found	Remarks

Date August 10, 1949, 19

APPROVED Hope Natural Gas Company, Owner

By _____ (Title)

(Title) *[Signature]*