

615-A	S 2.50
#2	W 0.48
S.O. Ensbuts	
618-A	S 3.08
#19	W 1.13
619-A	S 2.72
#25	W 1.41
614-A	S 2.68
#27	W 1.32
622-A	S 2.90
#41	W 1.32
623-A	S 2.97
#40	W 1.22

- New Location
- Drill Deeper
- Abandonment

~~TYL-615-A-2~~  
~~TYL-618-A-19~~  
~~TYL-619-A-25~~

Company J.R. Bull  
 Address Sistersville, W.Va.  
 Farm F.R. Wells  
 Tract 1 Acres 478 Lease No. 6102-03  
 Well (Farm) No. 40 Serial No. 19-41-25  
 Elevation (Spirit Level) 40-817' 27-624' 25-620'  
 Quadrangle New Matamoras  
 County Tyler District Lincoln  
 Engineer Don L. Riggle  
 Approved by George R. Clarke  
 Engineer's Registration No. 102  
 File No. 046-S.P.11 Drawing No. 1382  
 Date Apr. 29, '48 Scale 1" = 60'

STATE OF WEST VIRGINIA  
 DEPARTMENT OF MINES  
 OIL AND GAS DIVISION  
 CHARLESTON

**WELL LOCATION MAP**  
 FILE NO. ~~TYL-614-A-27~~  
~~TYL-622-A-31~~  
~~TYL-623-A-40~~

+ Denotes location of well on United States Topographic Maps, scale 1 to 62,500, latitude and longitude lines being represented by border lines as shown.

- Denotes one inch spaces on border line of original tracing.

F. R. WELLS NO. 19 WELL.

618A

Lincoln District, Tyler County, W. Va.  
By Maurice Horowitz, 310 N. McKean St., Butler, Pa.  
Abandoned under permit Tyl-.....-A?  
On.....acres.  
Elevation, .....' L.  
Date of completion, etc., not given.  
10" casing, 130' (pulled); 8 $\frac{1}{4}$ " , 960' (pulled); 6 $\frac{5}{8}$ " , 1375'.  
Oil well. Record to Dept. of Mines stamped April 17, 1950.  
Record to RGT from Mrs. Griffith May 26, 1950. Old File No. 544.

	Top.	Bottom.
Big Injun Sand	1777 -	....
Total depth		1820

"All that is given on record."



STATE OF WEST VIRGINIA  
DEPARTMENT OF MINES  
OIL AND GAS DIVISION

744

Permit No. TYL-218-A

WELL RECORD

Oil or Gas Well oil  
(KIND)


Company Maurice Horowitz  
Address 310 N. McKean St., Butler Penna.  
Farm F. R. Wells Acres \_\_\_\_\_  
Location (waters) \_\_\_\_\_  
Well No. 19 Elev. \_\_\_\_\_  
District Lincoln County Tyler  
The surface of tract is owned in fee by \_\_\_\_\_  
Address \_\_\_\_\_  
Mineral rights are owned by \_\_\_\_\_  
Address \_\_\_\_\_  
Drilling commenced \_\_\_\_\_  
Drilling completed \_\_\_\_\_  
Date Shot \_\_\_\_\_ From \_\_\_\_\_ To \_\_\_\_\_  
With \_\_\_\_\_  
Open Flow \_\_\_\_\_ /10ths Water in \_\_\_\_\_ Inch  
\_\_\_\_\_ /10ths Merc. in \_\_\_\_\_ Inch  
Volume \_\_\_\_\_ Cu. Ft.  
Rock Pressure \_\_\_\_\_ lbs. \_\_\_\_\_ hrs.  
Oil \_\_\_\_\_ bbls., 1st 24 hrs.  
Fresh water \_\_\_\_\_ feet  
Salt water \_\_\_\_\_ feet

Casing and Tubing	Used in Drilling	Left in Well	Packers
Size			
16			Kind of Packer
13			
10	130	None	Size of
8 1/4	960	None	
6 5/8	1375	1375	Depth set
5 3/16			
3			Perf. top
2			Perf. bottom
Liners Used			Perf. top
			Perf. bottom

CASING CEMENTED \_\_\_\_\_ SIZE \_\_\_\_\_ No. Ft. \_\_\_\_\_ Date \_\_\_\_\_

COAL WAS ENCOUNTERED AT \_\_\_\_\_ FEET \_\_\_\_\_ INCHES  
\_\_\_\_\_ FEET \_\_\_\_\_ INCHES \_\_\_\_\_ FEET \_\_\_\_\_ INCHES  
\_\_\_\_\_ FEET \_\_\_\_\_ INCHES \_\_\_\_\_ FEET \_\_\_\_\_ INCHES

Formation	Color	Hard or Soft	Top	Bottom	Oil, Gas or Water	Depth Found	Remarks
Big Injun			1777	Total Depth 1820			All that is given on record

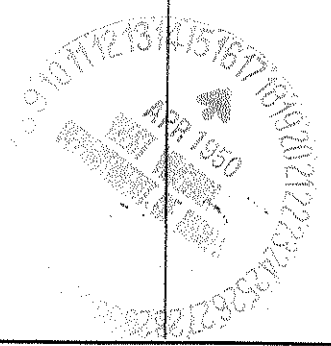

(Over)

MAY 26 1950