


Latitude 39° 35'

Longitude 80° 55'



| | |
|-------|--------|
| 627-A | S 1.07 |
| #5 | W 3.43 |
| 628-A | S 1.02 |
| #7 | W 3.19 |
| 629-A | S 1.07 |
| #9 | W 3.06 |

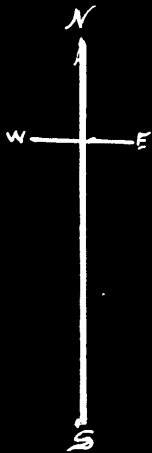

| | |
|-------|--------|
| 630-A | S 1.22 |
| #12 | W 3.20 |
| 631-A | S 1.10 |
| #13 | W 3.26 |

- TYL-626-A - 2
- TYL-627-A - 5
- TYL-628-A - 7
- TYL-629-A - 9
- TYL-630-A - 12
- TYL-631-A - 13

Company J. R. Bull
 Address Sistersville, W. Va.
 Farm J. R. Dunfee
 Tract 1 Acres 100 Lease No. 6091
 Well (Farm) No. 2, 5, 7, 9, 12, 13 Serial No. _____
 Elevation (Spirit Level) No. 2-948' No. 7-892' No. 12-1007' No. 5-991' No. 9-1068' No. 13-983'
 Quadrangle New Martinsville
 County Tyler District Lincoln
 Engineer Don L. Riggle
 Approved by George R. Clarke
 Engineer's Registration No. 102
 File No. 046-SP. 11 Drawing No. 1391
 Date May 20, '48 Scale 1" = 30p

STATE OF WEST VIRGINIA
 DEPARTMENT OF MINES
 OIL AND GAS DIVISION
 CHARLESTON

WELL LOCATION MAP
 FILE NO. _____

+ Denotes location of well on United States Topographic Maps, scale 1 to 62,500, latitude and longitude lines being represented by border lines as shown.
 - Denotes one inch spaces on border line of original tracing.

J. R. DUNFEE NO. 9 WELL.

629A

Lincoln District, Tyler County, W. Va.
By Maurice Horewitz, 310 N. McKean St., Butler, Pa.
Abandoned under permit Tyl-.....-A?
On.....acres.
Elevation,' L.
Date of completion, etc., not given.
6 $\frac{1}{4}$ " casing, 1400'.
Oil well. Record to Dept. of Mines stamped April 26, 1950.
Record to RCT from Mrs. Griffith Sept. 9, 1950. Old File No. 564.

| | |
|----------------|--------------|
| | Top. Bottom. |
| Big Injun Sand | 1831 - 1917 |

"All shown on record).



STATE OF WEST VIRGINIA
DEPARTMENT OF MINES
OIL AND GAS DIVISION

564

WELL RECORD

Permit No. TYL-629-A

Oil or Gas Well Oil
(KIND)

Company Maurice Horowitz
 Address 310 N. Mc Kean St. Butler Penna.
 Farm J.R. Dunfee Acres _____
 Location (waters) _____
 Well No. 9 Elev. _____
 District Lincoln County Tyler
 The surface of tract is owned in fee by _____
 Address _____
 Mineral rights are owned by _____
 Address _____
 Drilling commenced _____
 Drilling completed _____
 Date Shot _____ From _____ To _____
 With _____
 Open Flow _____ /10ths Water in _____ Inch
 _____ /10ths Merc. in _____ Inch
 Volume _____ Cu. Ft.
 Rock Pressure _____ lbs. _____ hrs.
 Oil _____ bbls., 1st 24 hrs.
 Fresh water _____ feet _____ feet
 Salt water _____ feet _____ feet

| Casing and Tubing | Used in Drilling | Left in Well | Packers |
|-------------------|------------------|--------------|----------------|
| Size | | | Kind of Packer |
| 16 | | | |
| 13 | | | |
| 10 | | | Size of |
| 8 1/4 | | | |
| 6 3/4 | 1400 | 1400 | Depth set |
| 5 3/16 | | | |
| 3 | | | Perf. top |
| 2 | | | Perf. bottom |
| Liners Used | | | Perf. top |
| | | | Perf. bottom |

CASING CEMENTED _____ SIZE _____ No. Ft. _____ Date _____
 COAL WAS ENCOUNTERED AT _____ FEET _____ INCHES
 _____ FEET _____ INCHES FEET _____ INCHES
 _____ FEET _____ INCHES FEET _____ INCHES

| Formation | Color | Hard or Soft | Top | Bottom | Oil, Gas or Water | Depth Found | Remarks |
|-----------|-------|--------------|------|--------|-------------------|-------------|---------------------|
| Big Injun | | | 1831 | 1917 | | | All shown on record |

