

New Location   
 Drill Deeper   
 Abandonment

Company Clarence Beardmore  
 Address 809 5th St, Marietta Ohio  
 Farm Jenny Shinn  
 Tract \_\_\_\_\_ Acres 20 Lease No. \_\_\_\_\_  
 Well (Farm) No. 1 Serial No. \_\_\_\_\_  
 Elevation (Spirit Level) 1045  
 Quadrangle West Union  
 County Tyler District Meade  
 Engineer Robert J. Meredith  
 Engineer's Registration No. 256  
 File No. \_\_\_\_\_ Drawing No. \_\_\_\_\_  
 Date June 28 Scale 1 in = 20 Poles

STATE OF WEST VIRGINIA  
 DEPARTMENT OF MINES  
 OIL AND GAS DIVISION  
 CHARLESTON

**WELL LOCATION MAP**  
 FILE NO. TYL-649-A-1

+ Denotes location of well on United States Topographic Maps, scale 1 to 62,500, latitude and longitude lines being represented by border lines as shown.

- Denotes one inch spaces on border line of original tracing.



575

STATE OF WEST VIRGINIA  
DEPARTMENT OF MINES  
OIL AND GAS DIVISION

WELL RECORD

Permit No. Typ-649-02

Oil or Gas Well Gas  
(KIND)


Company C.E. Beardmore  
Address 809-5th St. Marietta, Ohio  
Farm Jenny Shinn Acres 20  
Location (waters) Little Sand  
Well No. 1 Elev. 1045'  
District meade County Tyler  
The surface of tract is owned in fee by Jenny Shinn  
Route 1 Address Middlebourne, W. Va.  
Mineral rights are owned by Same  
Address \_\_\_\_\_

Casing and Tubing	Used in Drilling	Left in Well	Packers
Size			(Tubing) Kind of Packer
16			
13			
10	293'	none	Size of 6x2
8 1/2	1105'	986'	
6 5/8	1708'	1708'	Depth set 1714
5 3/16			
3			Perf. top
2	1805'	1805'	Perf. bottom
Liners Used			Perf. top
			Perf. bottom

Drilling commenced 6-17-25  
Drilling completed 8-29-25  
Date Shot \_\_\_\_\_ From \_\_\_\_\_ To \_\_\_\_\_  
With \_\_\_\_\_  
Open Flow \_\_\_\_\_ /10ths Water in \_\_\_\_\_ Inch  
\_\_\_\_\_ /10ths Merc. in \_\_\_\_\_ Inch  
Volume 390,000 Cu. Ft.  
Rock Pressure 117 lbs. \_\_\_\_\_ hrs.  
Oil \_\_\_\_\_ bbls., 1st 24 hrs.  
Fresh water \_\_\_\_\_ feet \_\_\_\_\_ feet  
Salt water \_\_\_\_\_ feet \_\_\_\_\_ feet

CASING CEMENTED \_\_\_\_\_ SIZE \_\_\_\_\_ No. Ft. \_\_\_\_\_ Date \_\_\_\_\_  
COAL WAS ENCOUNTERED AT \_\_\_\_\_ FEET \_\_\_\_\_ INCHES  
\_\_\_\_\_ FEET \_\_\_\_\_ INCHES FEET \_\_\_\_\_ INCHES  
\_\_\_\_\_ FEET \_\_\_\_\_ INCHES FEET \_\_\_\_\_ INCHES

Formation	Color	Hard or Soft	Top	Bottom	Oil, Gas or Water	Depth Found	Remarks
<u>Pittsburg coal</u>			<u>660'</u>	<u>663'</u>			
<u>Pumpard-fittle</u>			<u>1020'</u>	<u>1053'</u>			
<u>" - Big</u>			<u>1100'</u>	<u>1140'</u>			
<u>Salt - 1</u>			<u>1455'</u>	<u>1570'</u>			
<u>- 2</u>			<u>1655'</u>	<u>1700'</u>			
<u>Mapon</u>			<u>1770'</u>	<u>1795'</u>	<u>Gas</u>	<u>1772-76</u>	
							<u>180' (?) tubing</u>

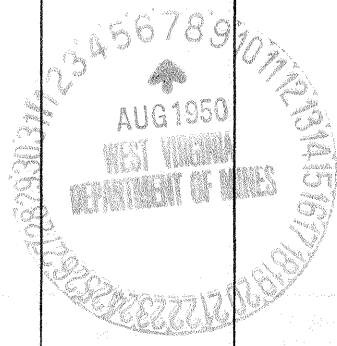

NOV 18 1950

