

New Location   
 Drill Deeper   
 Abandonment

Company J.R. Bull  
 Address Sistersville, W. Va.  
 Farm J. Clarke  
 Tract 1 Acres 60 Lease No. 6101  
 Well (Farm) No. 3 Serial No. \_\_\_\_\_  
 Elevation (Spirit Level) 853'  
 Quadrangle New Matamoras  
 County Tyler District Lincoln  
 Engineer Don L. Riggle  
 Approved by George R. Clarke  
 Engineer's Registration No. 102  
 File No. 046-S.P. 11 Drawing No. 1387  
 Date May 4, 48 Scale 1" = 40'

STATE OF WEST VIRGINIA  
 DEPARTMENT OF MINES  
 OIL AND GAS DIVISION  
 CHARLESTON

**WELL LOCATION MAP**  
 FILE NO. JYL-652-A

+ Denotes location of well on United States Topographic Maps, scale 1 to 62,500, latitude and longitude lines being represented by border lines as shown.

- Denotes one inch spaces on border line of original tracing.

J. A. CLARK NO. 3 WELL.

Lincoln District, Tyler County, W. Va. (?)

By Maurice Horowitz, 310 N. McKean St., Butler, Pa.

Abandoned under permit Tyl-.....-A?

On.....acres.

Elevation, .....' L.

Date of completion, etc., not given.

6 $\frac{1}{4}$ " casing, 1209'.

Oil well. Record to Dept. of Mines stamped Aug. 26, 1950.

Record to RCT from Mrs. Griffith Nov. 18, 1950. Old File No. 565.

	Top.	Bottom.
Big Injun Sand (oil)	1605	- 1655

("All that is given in record".)



STATE OF WEST VIRGINIA  
DEPARTMENT OF MINES  
OIL AND GAS DIVISION

535

WELL RECORD

Permit No. TYL-652-A

Oil or Gas Well X  
(KIND)

Company Mourice Harowitz  
 Address 310 N. McKean St. Butler Penna.  
 Farm J. A. Clark Acres \_\_\_\_\_  
 Location (waters) \_\_\_\_\_  
 Well No. 13 Elev. \_\_\_\_\_  
 District \_\_\_\_\_ County \_\_\_\_\_  
 The surface of tract is owned in fee by \_\_\_\_\_  
 Address \_\_\_\_\_  
 Mineral rights are owned by \_\_\_\_\_  
 Address \_\_\_\_\_  
 Drilling commenced \_\_\_\_\_  
 Drilling completed \_\_\_\_\_  
 Date Shot \_\_\_\_\_ From \_\_\_\_\_ To \_\_\_\_\_  
 With \_\_\_\_\_  
 Open Flow \_\_\_\_\_ /10ths Water in \_\_\_\_\_ Inch  
 \_\_\_\_\_ /10ths Merc. in \_\_\_\_\_ Inch  
 Volume \_\_\_\_\_ Cu. Ft.  
 Rock Pressure \_\_\_\_\_ lbs. \_\_\_\_\_ hrs.  
 Oil \_\_\_\_\_ bbls., 1st 24 hrs.  
 Fresh water \_\_\_\_\_ feet \_\_\_\_\_ feet  
 Salt water \_\_\_\_\_ feet \_\_\_\_\_ feet

Casing and Tubing	Used in Drilling	Left in Well	Packers
Size			Kind of Packer
16			
13			Size of
10			
8 1/4			Depth set
6 5/8	<b>1209</b>	<b>1209</b>	
5 3/16			Perf. top
3			Perf. bottom
2			Perf. top
Liners Used			Perf. bottom

CASING CEMENTED \_\_\_\_\_ SIZE \_\_\_\_\_ No. Ft. \_\_\_\_\_ Date \_\_\_\_\_


COAL WAS ENCOUNTERED AT \_\_\_\_\_ FEET \_\_\_\_\_ INCHES

\_\_\_\_\_ FEET \_\_\_\_\_ INCHES FEET \_\_\_\_\_ INCHES

\_\_\_\_\_ FEET \_\_\_\_\_ INCHES FEET \_\_\_\_\_ INCHES

Formation	Color	Hard or Soft	Top	Bottom	Oil, Gas or Water	Depth Found	Remarks
Injun			1605	1655	Oil		All that is given in record

C

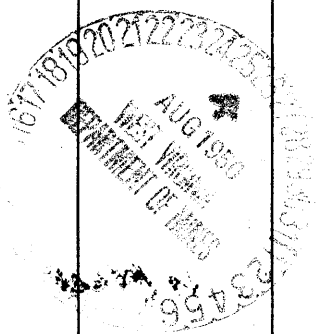

(Over)

NOV 1 9 1950