

Latitude

3935

80 5930

Longitude  
7.5' loc  
104  
91.185

Topo Location

7.5' Loc. 1835 15' Loc. 1835  
0.00W (calc.) 2.22W

Company \_\_\_\_\_

Farm Anna Fox I

15' Quad New Martinsville SC  
(sec.)

7.5' Quad Paden City


District Ellsworth

WELL LOCATION PLAT

County 095 Permit 30705

80 50  
05 08

60° 10'

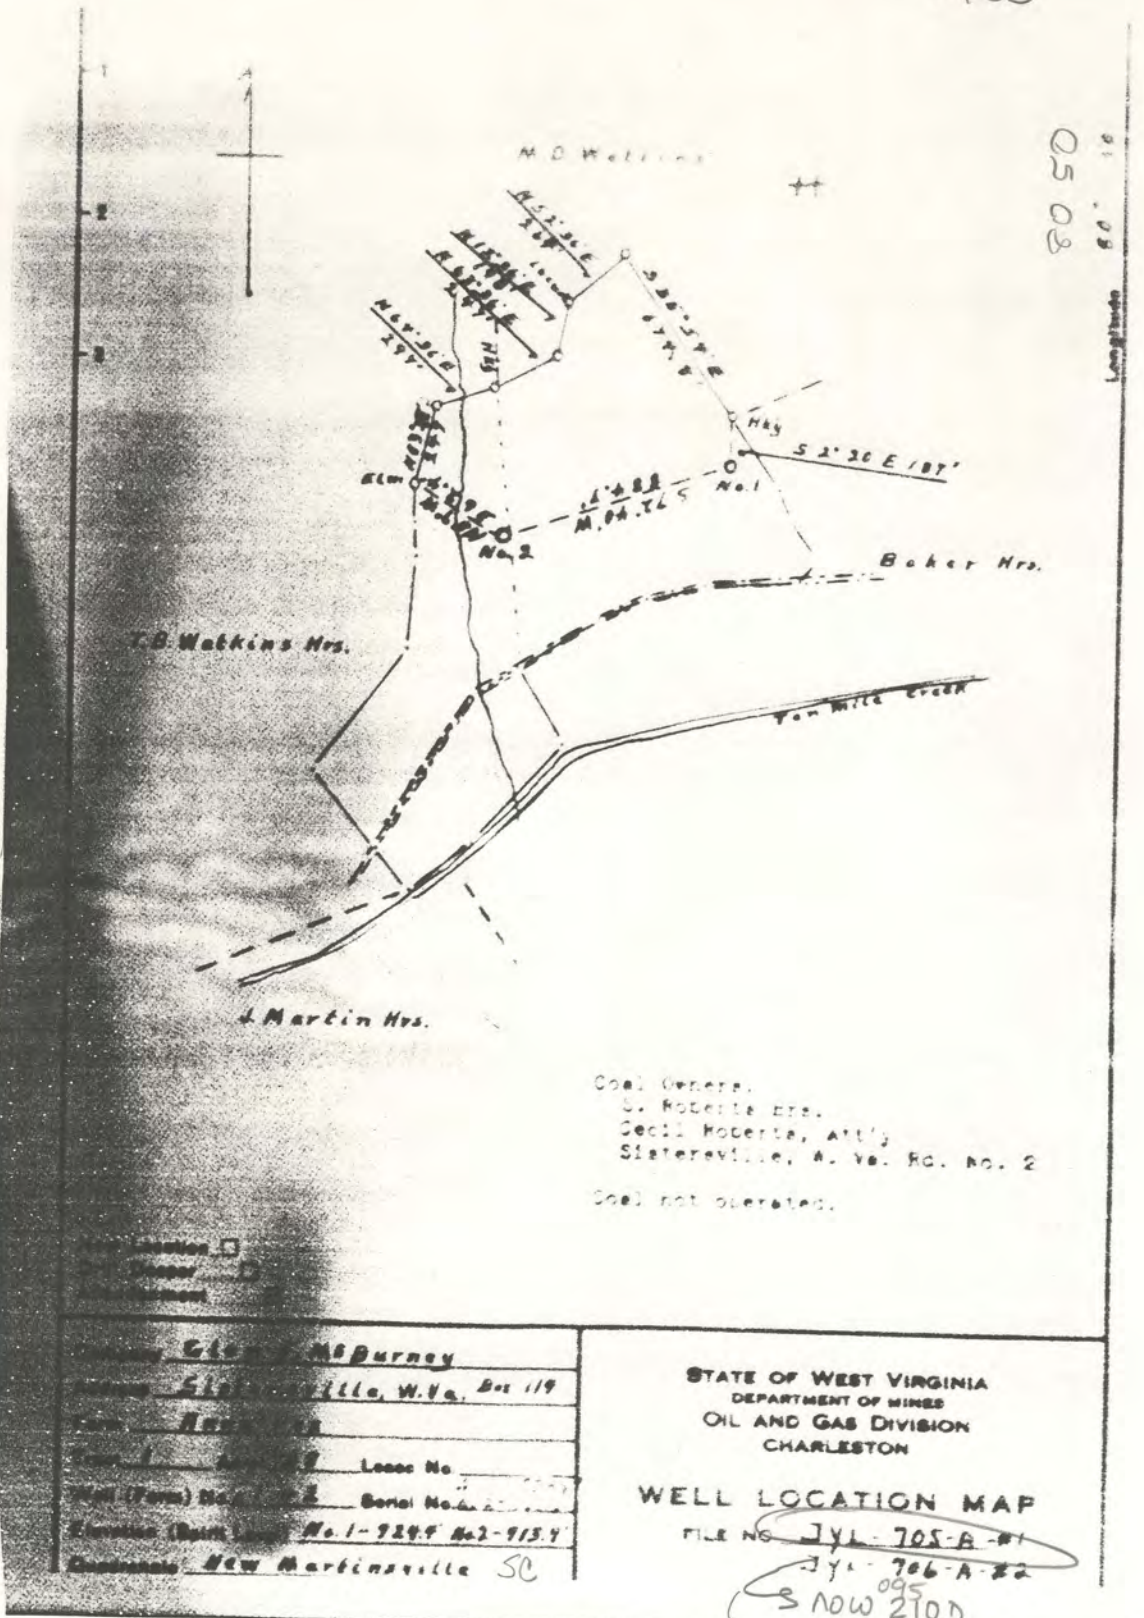

Coal Genera.  
 U. Roberts Mrs.  
 Cecil Roberts, Att'y  
 Sistersville, A. Va. RC. No. 2  
 Coal not operated.

Section  
 Township  
 County

Name Glen M. Burney  
 Address Sistersville, W. Va. Box 119  
 Phone None  
 Title None Lease No. None  
 Well (Form) No. None Serial No. None  
 Location (Bath Log) No. 1-9249 No. 2-9154  
 Coordinates New Martinsville SC

STATE OF WEST VIRGINIA  
 DEPARTMENT OF MINES  
 OIL AND GAS DIVISION  
 CHARLESTON

**WELL LOCATION MAP**  
 FILE NO. JYL-705-A-#1  
JYL-706-A-#2  
095  
S NOW 210D

ANNA FOX NO. 1 WELL.

Ellsworth District, Tyler County, W. Va.

By McKinley Brothers, Pittsburgh, Pa.

Abandoned under permit Tyl-.....-A?

On 38 acres, on Tenmile Creek.

Elevation, 924.4' L.

Surface and minerals owned by Anna Fox, Middlebourne, W. Va.

Drilling commenced March 3, 1903; completed June 17, 1903.

Shot June 20, 1903, at 1706-1710', with 60 qts.

Wood conductor, 19'; 8 $\frac{1}{4}$ " casing, 972' (pulled); 4-7/8", 1660'. No liners.

No packer.

Oil well. Record to Dept. of Mines not dated or stamped.

Record to RCT from Mrs. Griffith July 9, 1952. O. F. No. 656.

	Top.	Bottom.
Red clay and brown shale	0	- 1280
Sand, brown, hard	1280	- 1470
Lime shells, white, soft	1470	- 1625
Sand, white, hard	1625	- 1658
Shale, black, hard	1658	- 1660
Lime, white, hard	1660	- 1685
Sand, brown, hard (oil, 1706-1710')	1685	- 1710
Total depth		1710



STATE OF WEST VIRGINIA  
DEPARTMENT OF MINES  
OIL AND GAS DIVISION

656

WELL RECORD

Permit No. TYL-705-A(?)

Oil or Gas Well OIL  
(KIND)

Company McKinley Brothers  
Address Pittsburgh, Pennsylvania  
Farm Anna Fox Acres 38  
Location (waters) Ten Mile Creek  
Well No. 1 Elev. 924.4  
District Ellsworth County Tyler  
The surface of tract is owned in fee by Same  
Address Middlebourne, W. Va.  
Mineral rights are owned by Same  
Address \_\_\_\_\_  
Drilling commenced March 3, 1903  
Drilling completed June 17, 1903  
Date Shot 6-20-03 From 1706' To 1710'  
With 60 qts.  
Open Flow /10ths Water in \_\_\_\_\_ Inch  
/10ths Merc. in \_\_\_\_\_ Inch  
Volume No report Cu. Ft.  
Rock Pressure No report lbs. \_\_\_\_\_ hrs.  
Oil \_\_\_\_\_ bbls., 1st 24 hrs.  
Fresh water \_\_\_\_\_ feet  
Salt water \_\_\_\_\_ feet

Casing and Tubing	Used in Drilling	Left in Well	Packers
Size			Kind of Packer <u>None</u>
<del>19'</del> <u>19'</u> wood conductor			
13			
10			Size of _____
8 1/4	<u>972'</u>	<u>Pulled</u>	
<del>4 7/8"</del>	<u>1660'</u>	<u>1660'</u>	Depth set _____
5 3/16			
3			Perf. top _____
2			Perf. bottom _____
Liners Used	<u>None</u>		Perf. top _____
			Perf. bottom _____

CASING CEMENTED \_\_\_\_\_ SIZE \_\_\_\_\_ No. Ft. \_\_\_\_\_ Date \_\_\_\_\_

COAL WAS ENCOUNTERED AT \_\_\_\_\_ FEET \_\_\_\_\_ INCHES  
\_\_\_\_\_ FEET \_\_\_\_\_ INCHES  
\_\_\_\_\_ FEET \_\_\_\_\_ INCHES

Formation	Color	Hard or Soft	Top	Bottom	Oil, Gas or Water	Depth Found	Remarks
Red clay and shale	Brown	"	Surface	1280			
Sand	"	Hard	1280	1470			
Lime shells	White	Soft	1470	1625			
Sand	"	Hard	1625	1658			
Shale	Black	"	1658	1660			
Lime	White	"	1660	1685			
Sand	Brown	"	1685	1710	<u>OIL</u>	<u>1706-1710</u>	

(Over)

JUL 9 1952

DEPARTMENT OF MINES  
OIL AND GAS DIVISION

NOTICE OF INTENTION TO PLUG AND ABANDON WELL

(REQUIRED BY SECTION 6 ARTICLE 4 CHAPTER 22 OF THE CODE)

DEPARTMENT OF MINES,  
Charleston, W. Va.

None  
COAL OPERATOR OR COAL OWNER

Glenn F. McBurney  
NAME OF WELL OPERATOR

None  
ADDRESS

Box 114 - Stateville, W. Va.  
COMPLETE ADDRESS

None  
COAL OPERATOR OR COAL OWNER

March 22nd, 1951

WELL TO BE ABANDONED

None  
ADDRESS

Ellsworth District

None  
LEASE OR PROPERTY OWNER

Tyler County

None  
ADDRESS

Well No. 1 39° 35'  
40° 50'

Anna Fox Farm

Gentlemen:—

NOTIFY INSPECTOR OLIVER W. LINDBERG - HERRINGTON  
TELEPHONE 6627 - 24 HOURS IN ADVANCE OF PLUGGING DATE

The undersigned well operator is about to abandon the above described well and will commence

the work of plugging and abandoning said well on the \_\_\_\_\_ day of \_\_\_\_\_ 19\_\_\_\_  
(which date shall not be less than five days after the day on which this notice as mailed is received,  
or in due course should be received by the Department of Mines.)

This notice is given you in order that your respective representatives may be present at the  
plugging and filling of said well. You are further notified that whether you are represented or not  
represented the undersigned will proceed on that date, or shortly thereafter, to plug and fill said  
well in the manner required by Section 10, Article 4, Chapter 22 of the Code and given in detail on the  
reverse side of this notice, in "Work Order."

This notice is being mailed by registered mail to each of you at the above addresses on the  
above date.

Very truly yours,

*Glenn F. McBurney*



NOTE: Upon the abandonment of all wells drilled prior to 1940, the owner shall file a report with the Department of Mines, showing the depth and capacity in which the well is plugged and abandoned.

Tyler 705A

**AFFIDAVIT OF PLUGGING AND FILLING WELL**

AFFIDAVIT SHOULD BE MADE IN TRIPPLICATE, ONE COPY KEPT BY THE OPERATOR, ONE COPY TO BE RETURNED BY THE WELL OPERATOR AND THE THIRD COPY (THIS COPY SHOULD BE RETURNED) SHOULD BE KEPT BY EACH STATE OPERATOR AT THEIR RESPECTIVE HEADQUARTERS

NONE  
LEGAL OPERATOR OR OWNER  
 NONE  
ADDRESS  
 NONE  
LEGAL OPERATOR OR OWNER  
 NONE  
ADDRESS  
 NONE  
LEGAL OPERATOR OR OWNER

Glenn F. McBurney  
WELL OPERATOR  
 Box 114 Hintonville, N.Va.  
WELL OPERATOR ADDRESS  
 May 19th, 1921  
WELL AND LOCATION  
 Ellsworth  
District  
 Tyler  
County  
 Well No. 1  
 Anne Fox  
Farm  
 D.F. Desist  
STATE INSPECTOR SUPERVISING PLUGGING

STATE OF WEST VIRGINIA

County of *Wayne*

being first duly sworn according to law depose and say that *Glenn F. McBurney* and *Harry Haddock* are experienced in the work of plugging and filling oil and gas wells and were employed by *Glenn F. McBurney* well operator, and participated in the work of plugging and filling the above well, that said work was commenced on the *2nd* day of *May*, 19*21*, and that the well was plugged and filled in the following manner:

BAND OR ZONE RECORD	FILLING MATERIAL				FLUID USED	CASING	
	PERCENTAGE	WEIGHT	MEAS.	IN		SEE PAGE	SEE PAGE
sand and lime	red clay	1200	1200	4	120	120	
<p><i>(We could not pull this casing account of it being very poor, put three sacks of cement on 10 feet of casing stone and filled casing to top with red clay, at 200 feet or top of casing we put five sacks of cement on 10 feet of casing stone and then filled to top with red clay, placed amount of cement in 14" casing 6 feet high, as per instructions of Department of Mines.</i></p>							
COAL BEAMS	DESCRIPTION OF MONUMENT						
NAME: NONE	14" casing filled with cement and water thoroughly mixed and this pipe 14' high.						
NAME: NONE							
NAME: NONE							
NAME:							

and that the work of plugging and filling said well was completed on the *19th* day of *May*, 19*21*.

And further deponents saith not.

Sworn to and subscribed before me this

*Glenn F. McBurney*  
*Harry Haddock*  
 Day of *May*, 19*21*  
 Royal Weather