

Latitude

39 32 30

80 52 30

Longitude

7.5' loc  
→ K1a  
916195

**Topo Location**

7.5' Loc. 2.33S      15' Loc. 5.21S  
                  0.65W      (calc.) 2.87W

Company \_\_\_\_\_

Farm \_\_\_\_\_

15' Quad New Martinsville SC  
(sec.)

7.5' Quad Paden City

District Ellsworth

**WELL LOCATION PLAT**

County 095      Permit 30713

J. BENNETT HEIRS NO. 2 WELL.

Ellsworth District, Tyler County, W. Va.  
By Melrose Oil & Gas Co., Sistersville, W. Va.  
Abandoned under permit Tyl-.....-A?  
On 45 acres.

*Paducah*  
#1-30105-  
(1330)

Elevation, 955.6' L.

Minerals owned by Melrose Oil & Gas Co., Sistersville, W. Va.

Date of completion, etc., not given.

6 $\frac{5}{8}$ " casing, 1648'.

Oil well. Record to Dept. of Mines stamped May 9, 1951.

Record to RCT from Mrs. Griffith Aug. 17, 1951. Old File No. 613.

	Top.	Bottom.
Keener Sand (oil)	1930	1947

("All given on records")



613

STATE OF WEST VIRGINIA  
DEPARTMENT OF MINES  
OIL AND GAS DIVISION

WELL RECORD

Permit No. 77L-713-A

Oil or Gas Well Oil  
(KIND)


Company Melrose Oil & Gas Co.  
Address Sistersville West Virginia  
Farm J. Bennett Hrs. Acres 45  
Location (waters) \_\_\_\_\_  
Well No. 2 Elev. 955.6'  
District Ell worth County Tyler  
The surface of tract is owned in fee by \_\_\_\_\_  
Address \_\_\_\_\_  
Mineral rights are owned by Melrose Oil & Gas Co.  
Address Sistersville W. Va  
Drilling commenced \_\_\_\_\_  
Drilling completed \_\_\_\_\_  
Date Shot \_\_\_\_\_ From \_\_\_\_\_ To \_\_\_\_\_  
With \_\_\_\_\_  
Open Flow \_\_\_\_\_ /10ths Water in \_\_\_\_\_ Inch  
\_\_\_\_\_ /10ths Merc. in \_\_\_\_\_ Inch  
Volume \_\_\_\_\_ Cu. Ft.  
Rock Pressure \_\_\_\_\_ lbs. \_\_\_\_\_ hrs.  
Oil \_\_\_\_\_ bbls., 1st 24 hrs.  
Fresh water \_\_\_\_\_ feet \_\_\_\_\_ feet  
Salt water \_\_\_\_\_ feet \_\_\_\_\_ feet

Casing and Tubing	Used in Drilling	Left in Well	Packers
Size			
16			Kind of Packer _____
13			
10			Size of _____
8 1/4			
6 3/8	1648	1648	Depth set _____
5 3/16			
3			Perf. top _____
2			Perf. bottom _____
Liners Used			Perf. top _____
			Perf. bottom _____

CASING CEMENTED \_\_\_\_\_ SIZE \_\_\_\_\_ No. Ft. \_\_\_\_\_ Date \_\_\_\_\_

COAL WAS ENCOUNTERED AT \_\_\_\_\_ FEET \_\_\_\_\_ INCHES  
\_\_\_\_\_ FEET \_\_\_\_\_ INCHES FEET \_\_\_\_\_ INCHES  
\_\_\_\_\_ FEET \_\_\_\_\_ INCHES FEET \_\_\_\_\_ INCHES

Formation	Color	Hard or Soft	Top	Bottom	Oil, Gas or Water	Depth Found	Remarks
<b>Keener</b>			1930	1947	Oil		All Given On Record

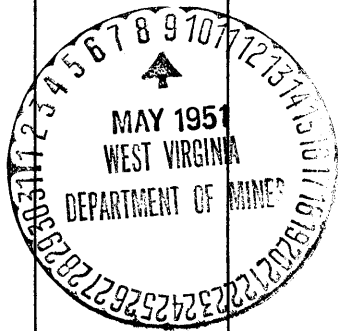

(Over)

AUG 17 1951