


Latitude 39° 35'

Longitude 80° 50'

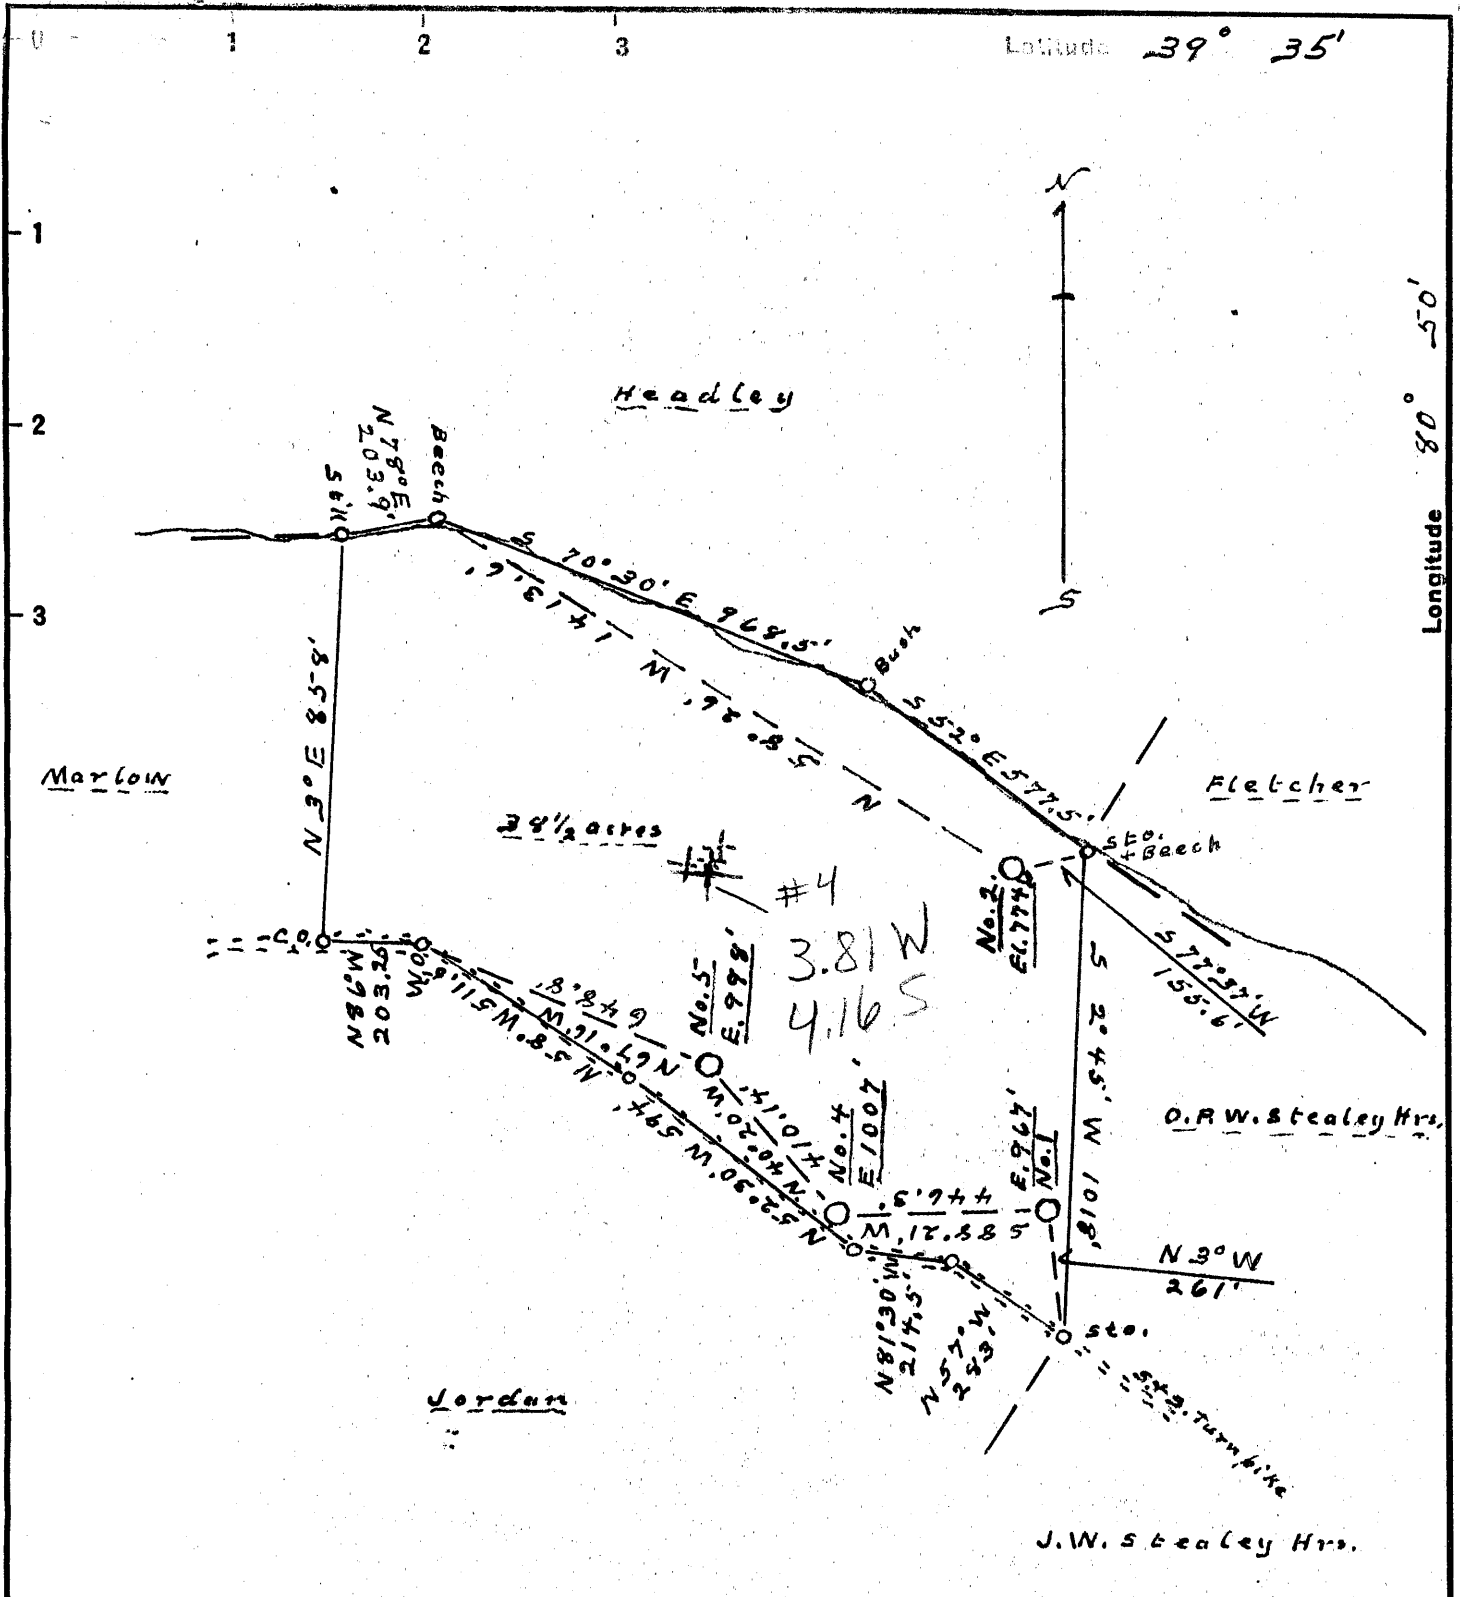

All wells previously located on U.S. Geo. topo. sheet

Coal Owner: W. Frye Sistersville, Rdd, W. Va.

Coal not operated.

New Location..
 Drill Deeper.....
 Abandonment.....

Company Malrose Oil & Gas Co.
 Address Sistersville, W. Va.
 Farm H.T. Marlow Hrs.
 Tract 1 Acres 38 1/2 Lease No. _____
 Well (Farm) No. 1-2-445 Serial No. _____
 Elevation (Spirit Level) No. 1-967' No. 4-1007'
No. 2-774' No. 5-998'
 Quadrangle New Martinsville
 County Tyler District Ellsworth
 Engineer J.W. Buchanan
 Engineer's Registration No. 60, Linniger
 File No. _____ Drawing No. _____
 Date 2-29-52 Scale 1" = 400'

STATE OF WEST VIRGINIA
 DEPARTMENT OF MINES
 OIL AND GAS DIVISION
 CHARLESTON

WELL LOCATION MAP
 FILE NO. JYL-805-A-#4
JYL-833-A-#2

+ Denotes location of well on United States Topographic Maps, scale 1 to 62,500, latitude and longitude lines being represented by border lines as shown.

- Denotes one inch spaces on border line of original tracing.



791

STATE OF WEST VIRGINIA
DEPARTMENT OF MINES
OIL AND GAS DIVISION

WELL RECORD

Permit No. 805-A



Oil or Gas Well Oil
(KIND)

Company Melrose Oil & Gas Co
 Address Sistersville W. Va.
 Farm A. T. Marlow Hrs Acres 38 1/2
 Location (waters) _____
 Well No. 4 Elev. 1007'
 District Ellsworth County Tyler
 The surface of tract is owned in fee by _____
 Address _____
 Mineral rights are owned by Melrose Oil Co
 Address Sistersville
 Drilling commenced _____
 Drilling completed _____
 Date Shot _____ From _____ To _____
 With _____
 Open Flow _____ /10ths Water in _____ Inch
 _____ /10ths Merc. in _____ Inch
 Volume _____ Cu. Ft.
 Rock Pressure _____ lbs. _____ hrs.
 Oil _____ bbls., 1st 24 hrs.
 Fresh water _____ feet _____ feet
 Salt water _____ feet _____ feet

Casing and Tubing	Used in Drilling	Left in Well	Packers
Size			
16			Kind of Packer
13			
10			Size of
8 1/4	1070	0	
6 3/4	1619	1619	Depth set
5 3/16		0	
3		0	Perf. top
2		0	Perf. bottom
Liners Used			Perf. top
			Perf. bottom

CASING CEMENTED _____ SIZE _____ No. Ft. _____ Date _____
 COAL WAS ENCOUNTERED AT _____ FEET _____ INCHES
 _____ FEET _____ INCHES FEET _____ INCHES
 _____ FEET _____ INCHES FEET _____ INCHES

Formation	Color	Hard or Soft	Top	Bottom	Oil, Gas or Water	Depth Found	Remarks
Keener							All that was given in record was the amount of 8 1/4 and 7" OD.

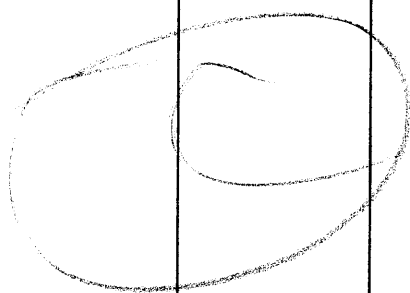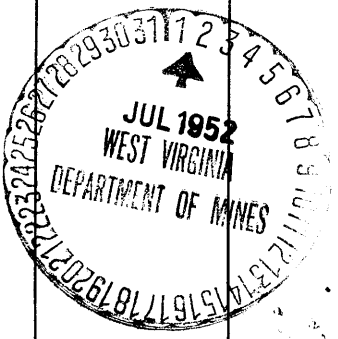

(Over) OCT 1 1953