

Latitude 39° 25'

Longitude 80° 50'

0.28 W  
2.59 S

0.28 W  
2161

MAR 9 1953

New Location   
 Drill Deeper   
 Abandonment

Company C. O. TRAVIS  
 Address WEST UNION, W. VA.  
 Farm LAWRENCE MERCER  
 Tract 5 Acres 16.4 Lease No. \_\_\_\_\_  
 Well (Farm) No. 1 Serial No. \_\_\_\_\_  
 Elevation (Spirit Level) 738'  
 Quadrangle WEST UNION.  
 County TYLER District CENTERVILLE  
 Engineer George R. Glushe  
 Surveyed by Home W. Myers  
 Engineer's Registration No. 102  
 File No. \_\_\_\_\_ Drawing No. \_\_\_\_\_  
 Date FEB. 7. 1953 Scale 1" = 500'

STATE OF WEST VIRGINIA  
 DEPARTMENT OF MINES  
 OIL AND GAS DIVISION  
 CHARLESTON

**WELL LOCATION MAP**  
 FILE NO. JYL-824-A

+ Denotes location of well on United States Topographic Maps, scale 1 to 62,500, latitude and longitude lines being represented by border lines as shown.

- Denotes one inch spaces on border line of original tracing.



STATE OF WEST VIRGINIA  
DEPARTMENT OF MINES  
OIL AND GAS DIVISION

712

WELL RECORD

Permit No. AK 804-A


Oil or Gas Well Gas  
(KIND)


Company C. O. Travis  
Address West Union, W. Va.  
Farm Thomas Acres 16.4  
Location (waters) Little Camp Mistake  
Well No. 1 Elev. 738  
District Centerville County Tyler  
The surface of tract is owned in fee by Lawrence Mercer  
Address Wilbur, W. Va.  
Mineral rights are owned by Lawrence Mercer  
Address Wilbur, W. Va.  
Drilling commenced \_\_\_\_\_  
Drilling completed \_\_\_\_\_  
Date Shot \_\_\_\_\_ From \_\_\_\_\_ To \_\_\_\_\_  
With \_\_\_\_\_

Casing and Tubing	Used in Drilling	Left in Well	Packers
Size			Kind of Packer
16			
13			
10			Size of
8 1/4			
6 1/2	1575	1575	Depth set
5 3/16			
3			Perf. top
2			Perf. bottom
Liners Used			Perf. top
			Perf. bottom

Open Flow \_\_\_\_\_ /10ths Water in \_\_\_\_\_ Inch  
\_\_\_\_\_ /10ths Merc. in \_\_\_\_\_ Inch  
Volume \_\_\_\_\_ Cu. Ft.  
Rock Pressure \_\_\_\_\_ lbs. \_\_\_\_\_ hrs.  
Oil \_\_\_\_\_ bbls., 1st 24 hrs.  
Fresh water \_\_\_\_\_ feet \_\_\_\_\_ feet  
Salt water \_\_\_\_\_ feet \_\_\_\_\_ feet

CASING CEMENTED \_\_\_\_\_ SIZE \_\_\_\_\_ No. Ft. \_\_\_\_\_ Date \_\_\_\_\_  
COAL WAS ENCOUNTERED AT No Coal FEET \_\_\_\_\_ INCHES  
\_\_\_\_\_ FEET \_\_\_\_\_ INCHES FEET \_\_\_\_\_ INCHES  
\_\_\_\_\_ FEET \_\_\_\_\_ INCHES FEET \_\_\_\_\_ INCHES

Formation	Color	Hard or Soft	Top	Bottom	Oil, Gas or Water	Depth Found	Remarks
Little Lime			1575	1610	 Gas	1771	
Pencil Cave			1610	1617			
Big Lime			1617	1687			
Big Ingun			1687	1800			
Squaw Sand			1802	1858			
Total Depth				1904			

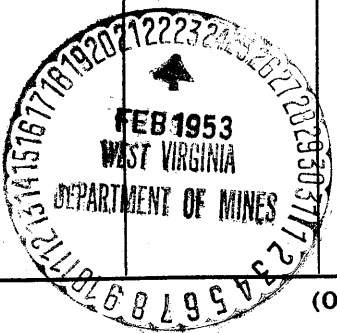

(Over) JUN 10 1953

Formation	Color	Hard or Soft	Top	Bottom	Oil, Gas or Water	Depth Found	Remarks

Date Feb - 11, 1953, 19

APPROVED E. O. Travis, Owner

By E. O. Travis  
(Title)