

Company Pierson, Smith, Feick & Kirkbride  
 Address 12, Walker W. Va.  
 Farm O. Pitts  
 Tract \_\_\_\_\_ Acres 50 Lease No. \_\_\_\_\_  
 Well (Farm) No. 6 Serial No. \_\_\_\_\_  
 Elevation (Spirit Level) 1086.2  
 Quadrangle Centerpoint  
 County Tyler District M<sup>c</sup>Elroy  
 Engineer Robert R. Anderson  
Omaradith  
 Engineer's Registration No. 296  
 File No. \_\_\_\_\_ Drawing No. \_\_\_\_\_  
 Date June 29, 54 Scale 1 in = 20 poles

STATE OF WEST VIRGINIA  
 DEPARTMENT OF MINES  
 OIL AND GAS DIVISION  
 CHARLESTON

WELL LOCATION MAP  
 FILE NO. JYL-837-A

+ Denotes location of well on United States Topographic Maps, scale 1 to 62,500, latitude and longitude lines being represented by border lines as shown.

- Denotes one inch spaces on border line of original tracing.

O. PITTS NO. 6 - PIERSON, SMITH, FEICK & KIRKBRIDE - TYL-837



STATE OF WEST VIRGINIA  
DEPARTMENT OF MINES  
OIL AND GAS DIVISION

741

WELL RECORD

Quadrangle Antietam

Permit No. 507A

Oil or Gas Well X (KIND)


Company Riersol, Smith, Peick & Kirkbride  
 Address Walker, rt, 2 W. A  
 Farm Oliver Fitts, Acres 50  
 Location (waters) of Indian Creek  
 Well No. 6 Elev. 1086.2  
 District McClroy County Tyler  
 The surface of tract is owned in fee by W.H Long  
Sisterville Address W.VA  
 Mineral rights are owned by Harley Moyers, Agt,  
rt, 4 Parkers Address W.VA  
 Drilling commenced 1910  
 Drilling completed same  
 Date Shot From To  
 With  
 Open Flow /10ths Water in Inch  
 /10ths Merc. in Inch  
 Volume Cu. Ft.  
 Rock Pressure lbs. hrs.  
 Oil bbls., 1st 24 hrs.  
 Fresh water feet feet  
 Salt water feet feet

Casing and Tubing	Used in Drilling	Left in Well	Packers
Size			
16			Kind of Packer
13			
10	328'	none	Size of
8 1/4	1383	none	
6 3/8	2333	none	Depth set
5 3/16	2373	2373	
<del>4 5/8</del>	<del>500'</del>	<del>500'</del>	Perf. top
2			Perf. bottom
Liners Used			Perf. top
			Perf. bottom

CASING CEMENTED SIZE No. Ft. Date

COAL WAS ENCOUNTERED AT FEET INCHES  
 FEET INCHES FEET INCHES  
 FEET INCHES FEET INCHES

Formation	Color	Hard or Soft	Top	Bottom	Oil, Gas or Water	Depth Found	Remarks
Clay & red rock & lime			000	2215'			
Big Injun sand			2215'	2379'			
slate shale & lime			2379'	2921'			
stray sand			2921'	2939'			
oil pay			2949'				
			total depth	2973'			

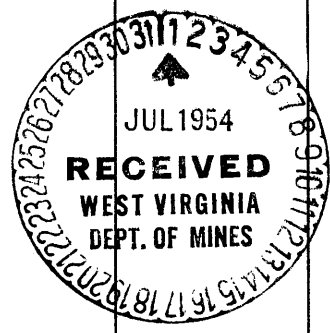

Formation	Color	Hard or Soft	Top	Bottom	Oil, Gas or Water	Depth Found	Remarks

Date 6 28, 1954

APPROVED Piersol Smith Feigh, Owner

By B. R. Piersol + Kirkbrede  
(Title)