


Latitude 39° 30'

Longitude 81° 00'

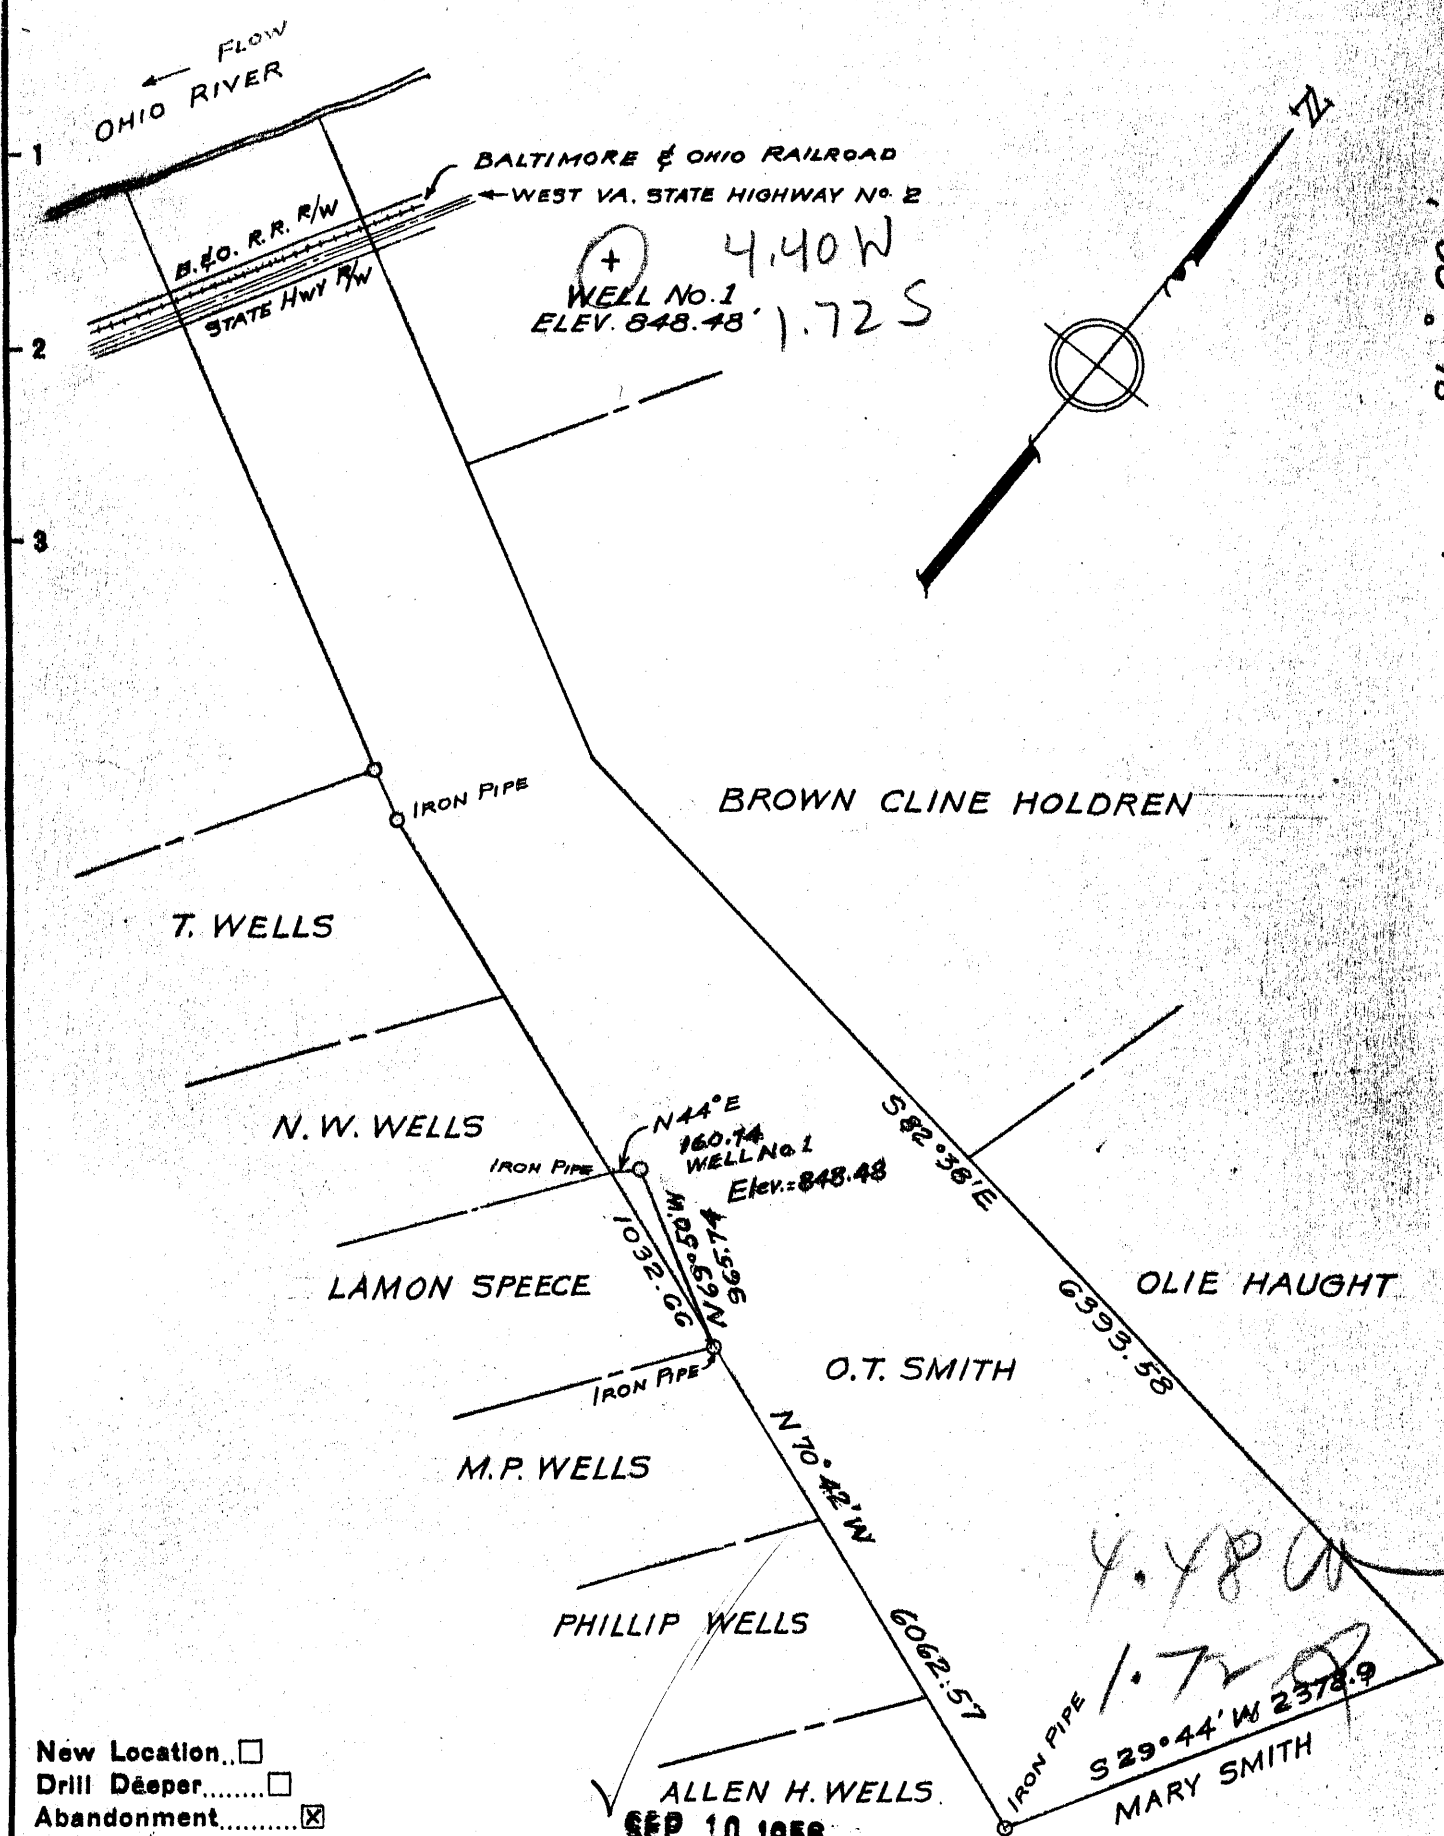

- New Location...
- Drill Deeper.....
- Abandonment.....

SEP. 10 1958

Company O.T. SMITH  
 Address FRIENDLY, W. VA.  
 Farm O.T. SMITH  
 Tract \_\_\_\_\_ Acres 31854 Lease No. \_\_\_\_\_  
 Well (Farm) No. 1 Serial No. \_\_\_\_\_  
 Elevation (Spirit Level) 848.48  
 Quadrangle ST. MARYS  
 County TYLER District UNION  
 Engineer L. G. MERRILL  
 Engineer's Registration No. 152  
 File No. \_\_\_\_\_ Drawing No. \_\_\_\_\_  
 Date MAY 31, 1954 Scale 1" = 1000'

STATE OF WEST VIRGINIA  
 DEPARTMENT OF MINES  
 OIL AND GAS DIVISION  
 CHARLESTON

WELL LOCATION MAP  
 FILE NO. JYL-843-A

+ Denotes location of well on United States Topographic Maps, scale 1 to 62,500, latitude and longitude lines being represented by border lines as shown.

- Denotes one inch spaces on border line of original tracing.

O.T. SMITH No. 1

O.T. SMITH -

TYL-843-A



STATE OF WEST VIRGINIA  
DEPARTMENT OF MINES  
OIL AND GAS DIVISION

746

Quadrangle ST. MARYS

Permit No. TYL-843 (plugging permit)

**WELL RECORD**

Oil or Gas Well OIL  
(KIND)

Company <u>Linde Air Products Co. (Now: H. &amp; H. Plugging Co)</u>	Casing and Tubing	Used in Drilling	Left in Well	Packers
Address <u>Williamstown, West Virginia</u>				
Farm <u>O. T. Smith</u> Acres <u>318.54</u>	Size			
Location (waters) <u>Ohio River</u>	16			Kind of Packer
Well No. <u>1</u> Elev. <u>848.48</u>	13			
District <u>Union</u> County <u>Tyler</u>	10			Size of
The surface of tract is owned in fee by _____	8 1/4			
Mineral rights are owned by <u>Linde Air Products Company</u>	6-1/4	838	838'	Depth set
<u>Tonawanda, N. Y.</u> Address _____	5 3/16 - 7/8"	1010	1010'	
Drilling commenced _____	3			Perf. top
Drilling completed <u>1892</u>	2	1695'	1695'	Perf. bottom
Date Shot _____ From _____ To _____	Liners Used	Same amt. of rods		Perf. top
With _____				Perf. bottom

Open Flow /10ths Water in \_\_\_\_\_ Inch  
/10ths Merc. in \_\_\_\_\_ Inch

Volume \_\_\_\_\_ Cu. Ft.

Rock Pressure \_\_\_\_\_ lbs. \_\_\_\_\_ hrs.

Oil \_\_\_\_\_ bbls., 1st 24 hrs.

Fresh water \_\_\_\_\_ feet \_\_\_\_\_ feet

Salt water \_\_\_\_\_ feet \_\_\_\_\_ feet

CASING CEMENTED \_\_\_\_\_ SIZE \_\_\_\_\_ No. Ft. \_\_\_\_\_ Date \_\_\_\_\_

COAL WAS ENCOUNTERED AT \_\_\_\_\_ FEET \_\_\_\_\_ INCHES  
\_\_\_\_\_ FEET \_\_\_\_\_ INCHES \_\_\_\_\_ FEET \_\_\_\_\_ INCHES  
\_\_\_\_\_ FEET \_\_\_\_\_ INCHES \_\_\_\_\_ FEET \_\_\_\_\_ INCHES

Formation	Color	Hard or Soft	Top	Bottom	Oil, Gas or Water	Depth Found	Remarks
ESTIMATED LOG:							
Big Lime			1480'				
Keener Sand (top)			1569				
Keener Sand (Bottom)			1604	Oil			
Big Injun			1625				
Total Depth (approximately)				1645			



APR 22 1955

(Over)