

COAL OWNED BY _____

NEW LOCATION.....

DRILL DEEPER.....

ABANDONMENT.....

✓ OCT 19 1955

102 W
143 S

COMPANY The Manufacturers Light & Heat

ADDRESS 800 Union Trust Bldg. Pgh. Pa.

FARM Jas. F. & Mary V. Powell

TRACT _____ ACRES 209 LEASE No. 2949

WELL (FARM) No. 3 SERIAL No. 2751

ELEVATION (SPIRIT LEVEL) 1014.38'

QUADRANGLE West Union

COUNTY Tyler DISTRICT McElroy

ENGINEER Robert M. Neill

ENGINEER'S REGISTRATION No. 361-E

FILE No. _____ DRAWING No. V-15-278

DATE 18 July 1955 SCALE 1"=800'

STATE OF WEST VIRGINIA
DEPARTMENT OF MINES
OIL AND GAS DIVISION
CHARLESTON

WELL LOCATION MAP

FILE No. JYL-860-A

+ DENOTES LOCATION OF WELL ON UNITED STATES TOPOGRAPHIC MAPS, SCALE 1 TO 62,500. LATITUDE AND LONGITUDE LINES BEING REPRESENTED BY BORDER LINES AS SHOWN.

- DENOTES ONE INCH SPACES ON BORDER LINE OF ORIGINAL TRACING.



STATE OF WEST VIRGINIA
DEPARTMENT OF MINES
OIL AND GAS DIVISION

761

Quadrangle _____

Permit No. 3102

WELL RECORD

Oil or Gas Well Gas
(KIND)


Company THE MANUFACTURERS LIGHT AND HEAT COMPANY
Address 800 UNION TRUST BLDG., PGH., PENNA.
Farm J. F. & Mary Powell Acres 209
Location (waters) _____
Well No. 2751 Elev. 1014.38'
District McElroy County Tyler
The surface of tract is owned in fee by _____
Address _____
Mineral rights are owned by _____
Address _____
Drilling commenced July 26, 1922
Drilling completed November 8, 1922
Date Shot _____ From _____ To _____
With _____
Open Flow _____ /10ths Water in _____ Inch
_____ /10ths Merc. in _____ Inch
Volume _____ Cu. Ft.
Rock Pressure _____ lbs. _____ hrs.
Oil _____ bbls., 1st 24 hrs.
Fresh water _____ feet _____ feet
Salt water _____ feet _____ feet

Casing and Tubing	Used in Drilling	Left in Well	Packers
Size			
16			Kind of Packer
13			
10	299'	Pulled	Size of
8 1/4	1117' 10"	1117' 10"	
6 3/4	1541' 8"	1541' 8"	Depth set
5 3/16	2247	2247	
3			Perf. top
2			Perf. bottom
Liners Used			Perf. top
			Perf. bottom

CASING CEMENTED _____ SIZE _____ No. Ft. _____ Date _____

COAL WAS ENCOUNTERED AT 225 FEET 44 1/2 INCHES
480 FEET INCHES 675 FEET INCHES
699 FEET INCHES 1065 FEET INCHES

Formation	Color	Hard or Soft	Top	Bottom	Oil, Gas or Water	Depth Found	Remarks
Red Mud			0	70			
Sand			70	100			
Slate			100	125			
Lime			125	150			
Sand			150	180			
Lime			180	225			
Coal			225	228			
Slate			228	247			
Lime			247	300			
Slate			300	317			
Lime			317	357			
Slate			357	370			
Lime			370	400			
Slate			400	410			
Sand			410	430			
Lime			430	445			
Coal			445	447			
Lime			447	460			
Lime			460	480			
Coal			480	482			
Lime			482	490			
Sand			490	510			
Lime			510	517			
Lime			517	580			
Sand			580	590			
Slate			590	610			
Sand			610	620			
Slate			620	627			
Lime			627	640			
Slate			640	660			
Lime			660	675			
Coal			675	680			
Lime			680	695			
Slate			695	699			
Coal			699	702			
Lime			702	724			
Sand			724	787			
Slate			787	800			
Lime			800	810			

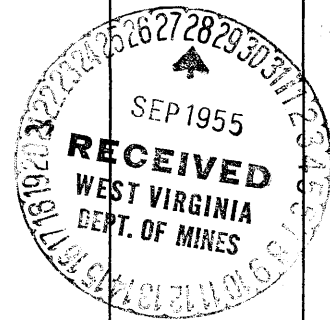

JUNE 21 1956

Formation	Color	Hard or Soft	Top	Bottom	Oil, Gas or Water	Depth Found	Remarks
Red rock			810	825			
Lime			825	837			
Slate			837	851			
Lime			851	866			
Sand			866	878			
Red Rock			878	885			
Lime			885	900			
Red rock			900	920			
Slate			920	940			
Red rock			940	950			
Lime			950	1030			
Red rock			1030	1040			
Lime			1040	1065			
Coal			1065	1069			
Slate			1069	1100			
Slate			1100	1107			
Lime			1107	1120			
Little Dunkard			1120	1150			
Slate			1150	1160			
Sand			1160	1170			
Slate			1170	1219			
Lime			1219	1226			
Sand			1226	1247			
Slate			1247	1283			
Sand			1283	1350			
Slate			1350	1360			
Slate			1360	1376			
Lime			1376	1393			
Slate			1393	1411			
1st Salt Sand			1411	1430			
Slate			1430	1460			
2nd Salt Sand			1460	1511			
Slate			1511	1540			
3rd Salt Sand			1540	1830			
Slate			1830	1875			
Maxon Sand			1875	1880			
Slate			1880	1900			
Little Lime			1900	1910			
Pencil Cave			1910	1914			
Big Lime			1914	1995			
Big Injun			1995	2205			
Ganta Sand			2330	2425			
Red rock			2536	2547			
Gordon			2770	2785			
Pay			2770	2775			
Total			2940				

Date September 27, 1955

APPROVED THE MANUFACTURERS LIGHT AND HEAT CO. Owner

By Walter A. Brown
ASST. LAND AGENT (Title)