


Latitude 39° 35'

Longitude 80° 55'

(+) 4.05 W
1.22 S

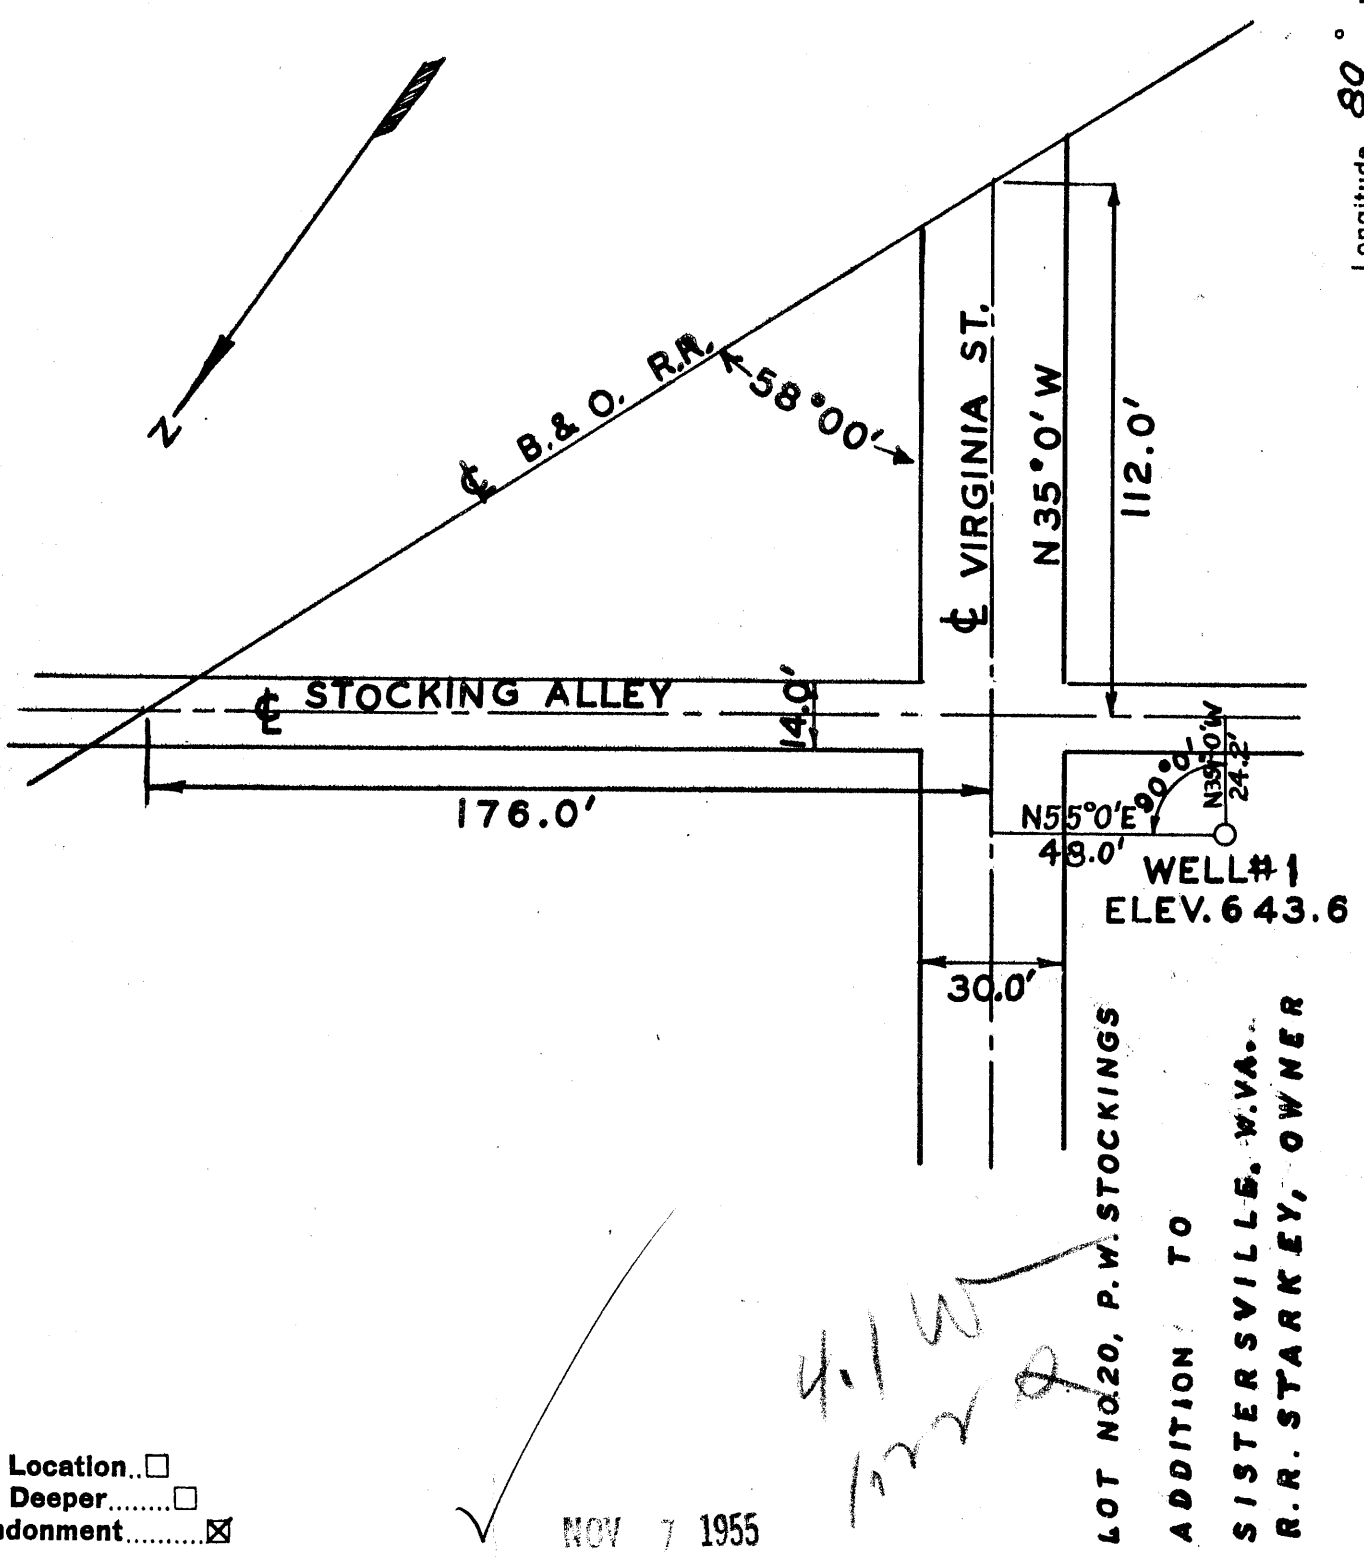

New Location...
 Drill Deeper.....
 Abandonment.....

NOV 7 1955

4.05 W
1.22 S

LOT NO. 20, P. W. STOCKINGS
 ADDITION TO
 SISTERSVILLE, W. VA.
 R. R. STARKEY, OWNER

Company MACKY & WHITE
 Address RAVEN ROCK, W. VA.
 Farm CITY LOT - R. R. STARKEY
 Tract _____ Acres 0.10 Lease No. _____
 Well (Farm) No. 1 Serial No. _____
 Elevation (Spirit Level) 643.6'
 Quadrangle NEW MARTINSVILLE, W. VA.
 County TYLER District LINCOLN
 Engineer E. M. COTTLE
 Engineer's Registration No. 889
 File No. _____ Drawing No. _____
 Date MAR. 17, 1955 Scale 1" = 40'-0"

STATE OF WEST VIRGINIA
 DEPARTMENT OF MINES
 OIL AND GAS DIVISION
 CHARLESTON

WELL LOCATION MAP
 FILE NO. JYL-865-A

+ Denotes location of well on United States Topographic Maps, scale 1 to 62,500, latitude and longitude lines being represented by border lines as shown.

- Denotes one inch spaces on border line of original tracing.

R. R. STARKEY NO. 1 - MACKY & WHITE - TYL-865-A



STATE OF WEST VIRGINIA
DEPARTMENT OF MINES
OIL AND GAS DIVISION

754

New Martinsville

Permit No. 85-A

WELL RECORD


Oil or Gas Well _____ (KIND)

Company Mackey & White
 Address Raven Rock, W.Va.
 Farm G.W. Stocking hrs. Lot Acres Lot
 Location (waters) Ohio River
 Well No. 1 Elev. 643.6
 District Lincoln County Tyler
 The surface of tract is owned in fee by R.R. Starkey
Sistersville, W.Va.
 Mineral rights are owned by G.W. Stocking hrs.
Sistersville, W.Va. 1996
 Drilling commenced _____
 Drilling completed 1896
 Date Shot _____ From _____ To _____
 With _____
 Open Flow _____ /10ths Water in _____ Inch
 _____ /10ths Merc. in _____ Inch
 Volume _____ Cu. Ft.
 Rock Pressure _____ lbs. _____ hrs.
 Oil Now dry _____ bbls., 1st 24 hrs.
 Fresh water _____ feet _____ feet
 Salt water _____ feet _____ feet

Casing and Tubing	Used in Drilling	Left in Well	Packers
Size			Kind of Packer
16			
13			
10	86	86	Size of
8 1/4	396	396	
xxx 6 1/4	1016	1016	Depth set
xxx 4 7/8	1331	1331	
3	4 7/8 run in later years to shut off water.		Perf. top
2	Tubing now pulled.		Perf. bottom
Liners Used			Perf. top
			Perf. bottom

CASING CEMENTED _____ SIZE _____ No. Ft. _____ Date _____
 COAL WAS ENCOUNTERED AT _____ FEET _____ INCHES
 _____ FEET _____ INCHES FEET _____ INCHES
 _____ FEET _____ INCHES FEET _____ INCHES

Formation	Color	Hard or Soft	Top	Bottom	Oil, Gas or Water	Depth Found	Remarks
		Big Lime Big Injun Bottom hole	1300 1397	1380 1466			

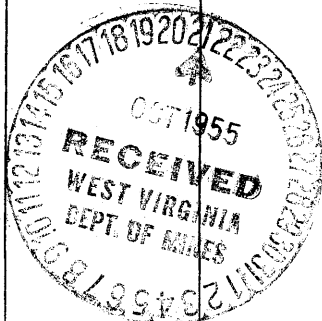

JAN. 23 1956

Formation	Color	Hard or Soft	Top	Bottom	Oil, Gas or Water	Depth Found	Remarks

Date Oct. 19, 1955

APPROVED Edw J. White, Owner

By Richard
(Title)

