


Latitude 37° 35'

Longitude 80° 55'

+ 3.96 W
1.16 S

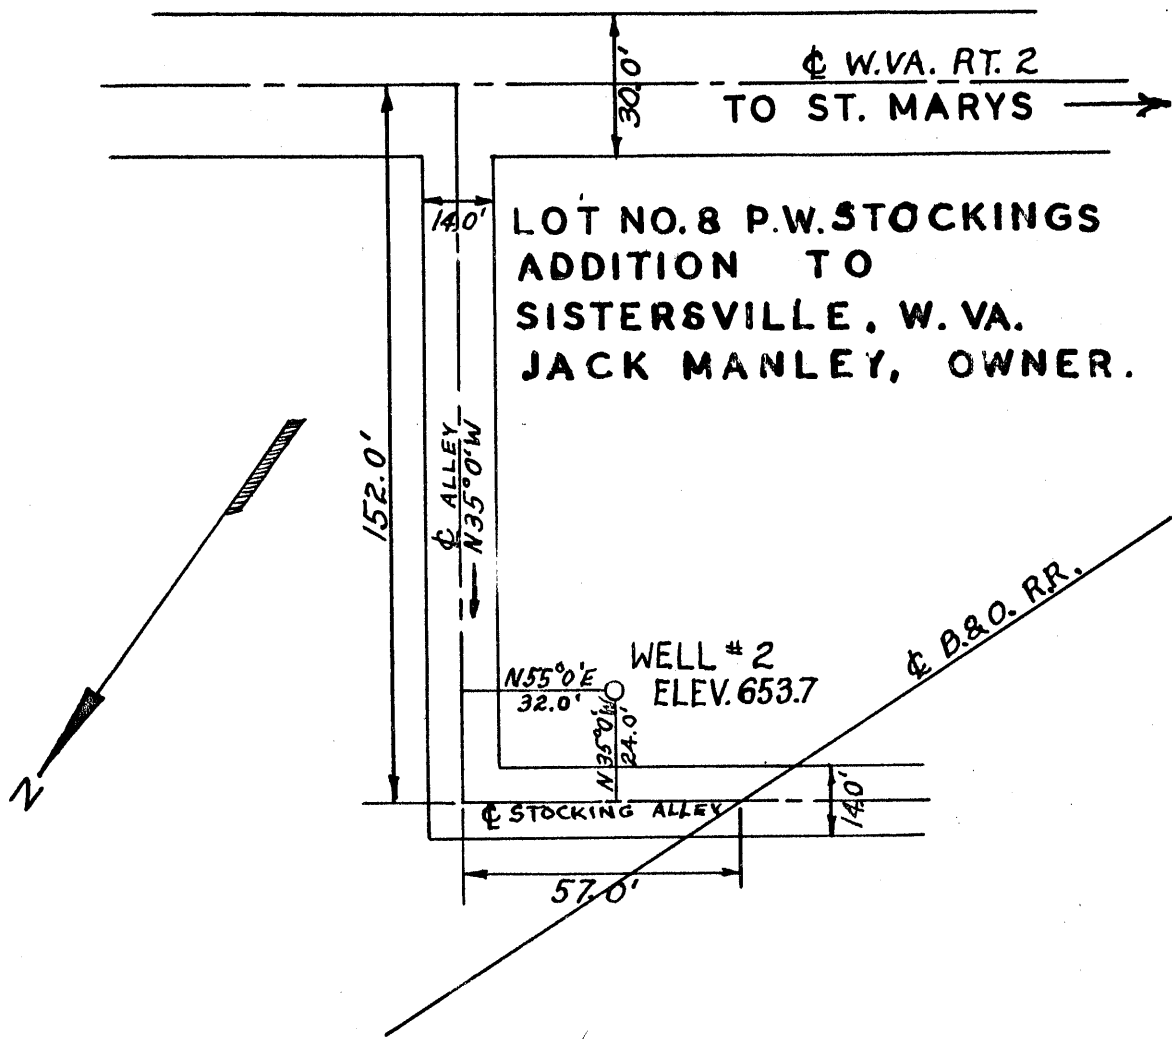

New Location..
 Drill Deeper.....
 Abandonment.....

DEC 27 1955

4.0 W
1.0 S

Company MACKAY & WHITE
 Address RAVEN ROCK, W. VA.
 Farm CITY LOT Jack Manley
 Tract _____ Acres 0.10 Lease No. _____
 Well (Farm) No. 2 Serial No. _____
 Elevation (Spirit Level) 653.7'
 Quadrangle NEW MARTINSVILLE, WVA
 County TYLER District LINCOLN
 Engineer E. N. Cottle
 Engineer's Registration No. 889
 File No. _____ Drawing No. _____
 Date MAR. 17, 1955 Scale 1" = 40'-00"

STATE OF WEST VIRGINIA
 DEPARTMENT OF MINES
 OIL AND GAS DIVISION
 CHARLESTON

WELL LOCATION MAP
 FILE NO. JYL-868-A

+ Denotes location of well on United States Topographic Maps, scale 1 to 62,500, latitude and longitude lines being represented by border lines as shown.

- Denotes one inch spaces on border line of original tracing.



STATE OF WEST VIRGINIA
DEPARTMENT OF MINES
OIL AND GAS DIVISION

79

WELL RECORD

Permit No. 79-868A

Oil or Gas Well (KIND)

Company Mackey & White
 Address Raven Rock, W.Va.
 Farm Jack Manley Acres lot
 Location (waters) City Sistersville
 Well No. 2 Elev. 653.7
 District Lincoln County Tyler
 The surface of tract is owned in fee by Jack Manley
Sistersville, W.Va. Address W.Va.
 Mineral rights are owned by Stocking hrs.
Sistersville Address W.Va.
 Drilling commenced about 1898
 Drilling completed _____
 Date Shot _____ From _____ To _____
 With _____
 Open Flow _____ /10ths Water in _____ Inch
 _____ /10ths Merc. in _____ Inch
 Volume _____ Cu. Ft.
 Rock Pressure _____ lbs. _____ hrs.
 Oil _____ bbls., 1st 24 hrs.
 Fresh water _____ feet _____ feet
 Salt water _____ feet _____ feet

Casing and Tubing	Used in Drilling	Left in Well	Packers
Size			
16			Kind of Packer
13			
10		85 ft.	Size of
8 7 1/2		273	
6%			Depth set
5 5/8		1040	
2 1/4		1330	Perf. top
2	None		Perf. bottom
Liners Used			Perf. top
			Perf. bottom

CASING CEMENTED _____ SIZE _____ No. Ft. _____ Date _____

COAL WAS ENCOUNTERED AT _____ FEET _____ INCHES

_____ FEET _____ INCHES FEET _____ INCHES

_____ FEET _____ INCHES FEET _____ INCHES

Formation	Color	Hard or Soft	Top	Bottom	Oil, Gas or Water	Depth Found	Remarks
Big Lime	1325	1365					
Injun Sand	1409						
	Total Depth	1458					

RECEIVED
 WEST VIRGINIA
 DEPT. OF MINES
 1955

JUNE 21 1956

Formation	Color	Hard or Soft	Top	Bottom	Oil, Gas or Water	Depth Found	Remarks

Date Dec. 8, 1955

APPROVED Edw. J. Mathews, Owner

By Mathews (Title)