


2,1176 E

Plot Log Card CSD Mfilm

Latitude 39 30

Longitude 80 45

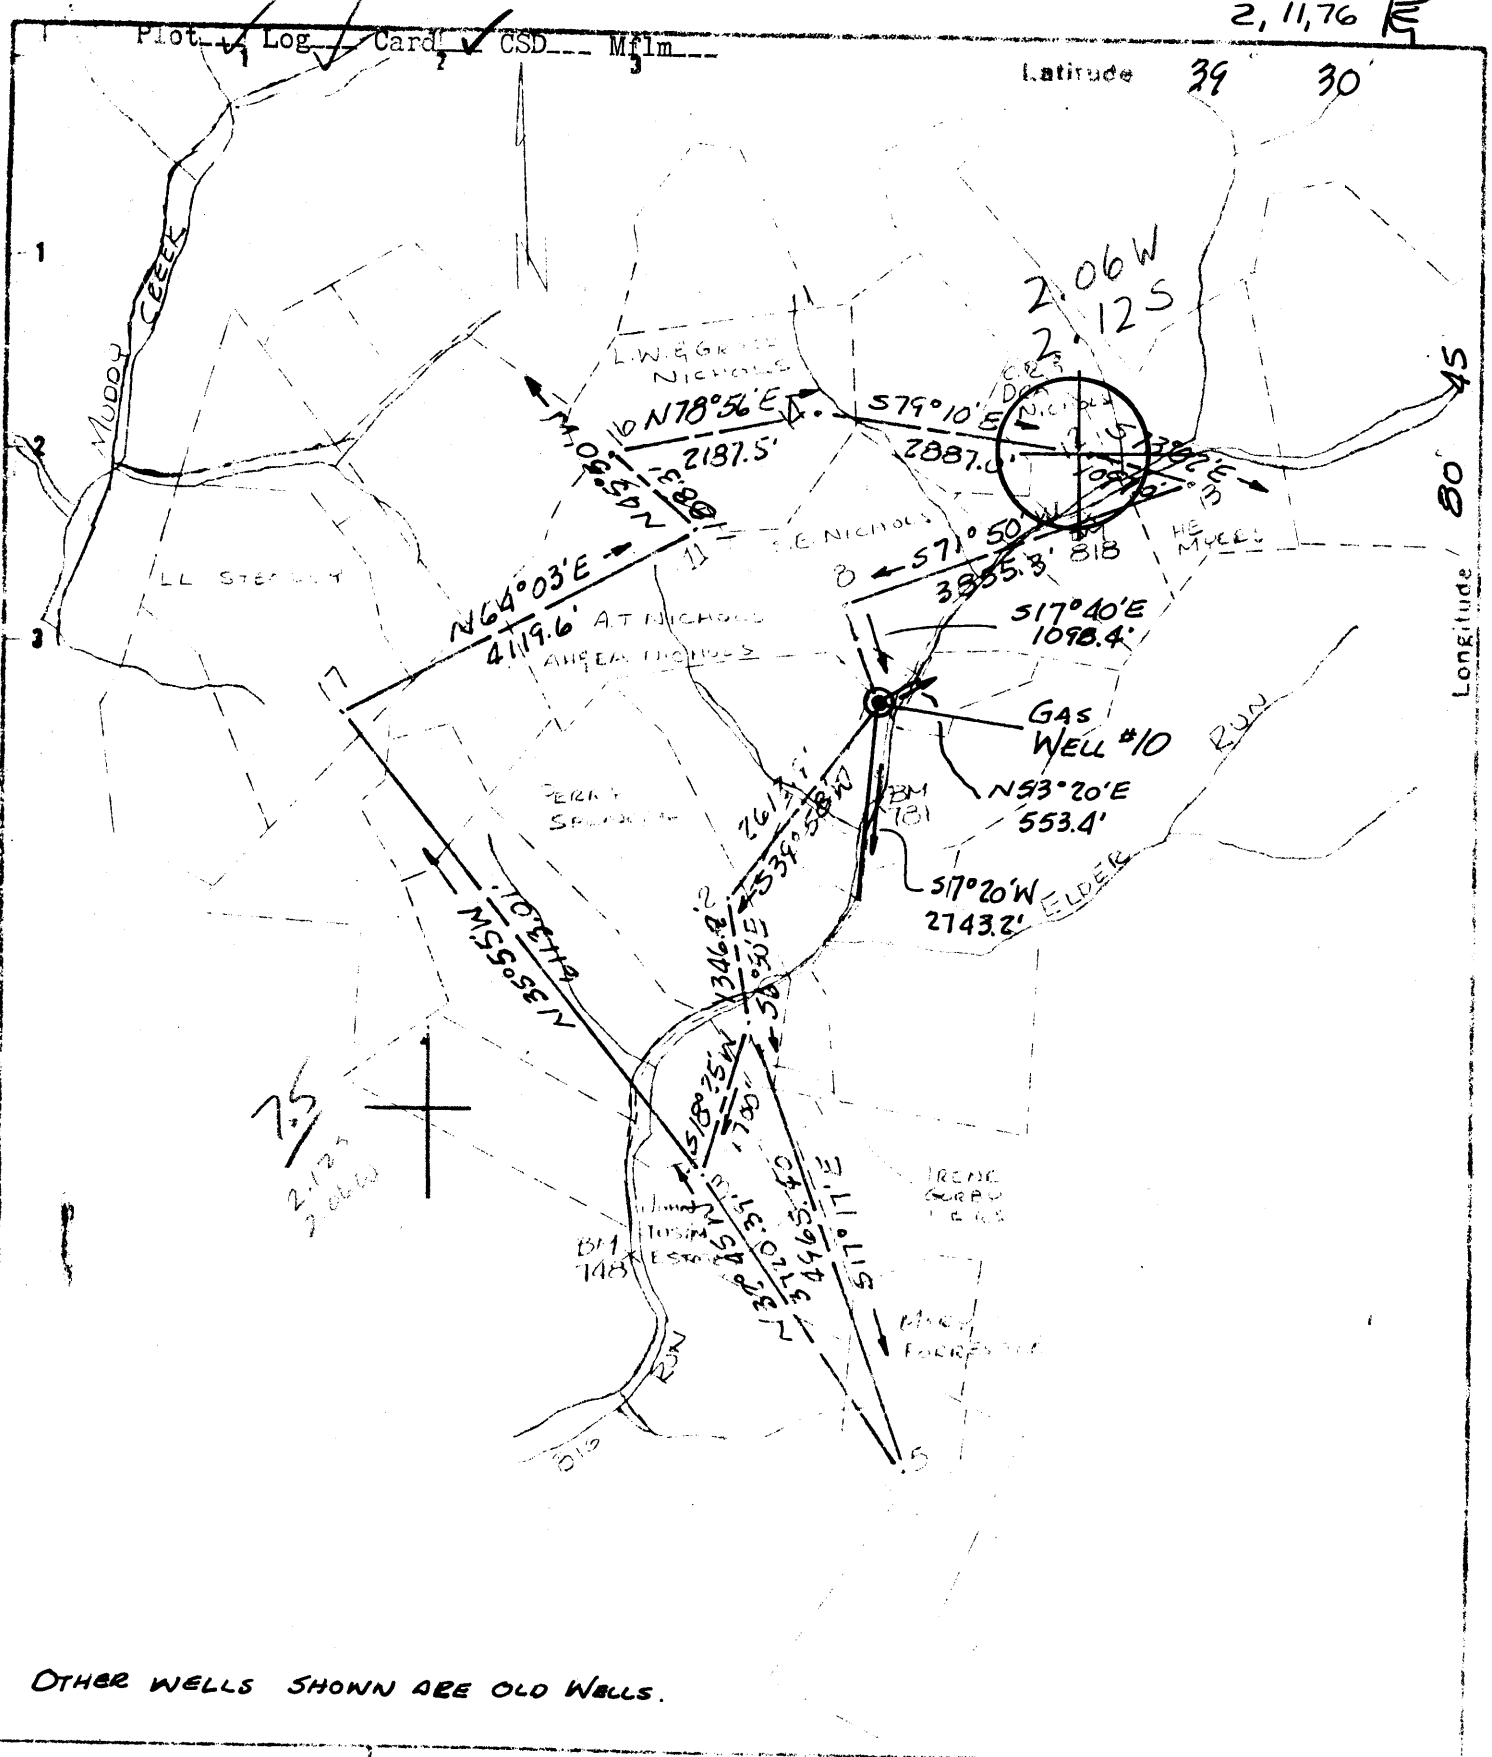

OTHER WELLS SHOWN ARE OLD WELLS.

<p>New Location <input type="checkbox"/></p> <p>Drill Deeper <input checked="" type="checkbox"/></p> <p>Abandonment <input checked="" type="checkbox"/></p> <p>2/11/75</p>	<p>Source of Elevation BM 781</p>
---	--

<p>Company Wilson Pipe & Supply</p> <p>Address STEPHENS ARKANSAS</p> <p>Farm A. T. NICHOLS</p> <p>Tract Acres 64</p> <p>Well No. 10</p>	<p>STATE OF WEST VIRGINIA</p> <p>DEPARTMENT OF MINES</p> <p>OFFICE OF OIL & GAS DIVISION</p>
--	--

825.35
 WEST UNION - NE
 McELROY

TYL-971-A