


LATITUDE 39° 32' 30"

LONGITUDE 80° 57' 30"

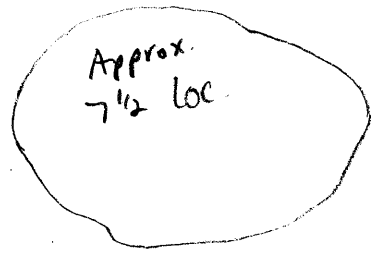

7'5 OGIS topo location

7.5' loc _____ 15' loc _____
 (calc.) _____

Company _____

Farm _____

Quad Paden City 7 1/2

County Tyler

District Union

WELL LOCATION MAP

File No. 095-70026 #66 MTW
095-70027 #69 Co. Rep
095-70028
095-70029

Union District, Tyler County, W. Va.
Reno Oil Co.
Elevation, 680'.
Oil well.
Completed in 1897.
On Buffalo Run.

*M. J. Anthony
Found*

7
1

Keener Sand (oil, 1543')
Total depth

Top.	Bottom.
1531	1563