


LATITUDE 39° 32' 30"

LONGITUDE 80° 57' 30"

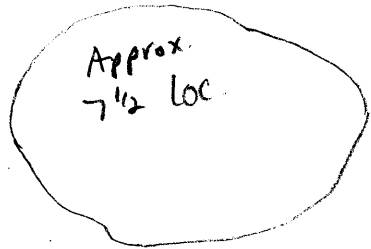

7'5 OGIS topo location

7.5' loc _____ 15' loc _____
(calc.) _____

Company _____

Farm _____

Quad Paden City 7 1/2

County Tyler

District Union

WELL LOCATION MAP

File No. 095-70026 #66 mth
095-70027 #69 Co. Plat
095-70028
095-70029

Union District, Tyler County, W. Va.
Reno Oil Co.
Elevation, 773' B.
Oil well.
Completed in 1917.
On Buffalo Run.

*No localities
found*

7

	Top.	Bottom.
Sand	151	179
Coal, Pittsburgh	223	225
Reds	540	555
Sand, Minshall	555	580
Red rock (Big Reds) (Cave)	590	638
Pink rock	740	775
Red rock	921	936
1st Salt Sand	1021	1061
2nd Salt Sand	1215	
3rd Salt Sand	1326	1356
Maxton Sand	1416	1456
Big Line	1542	1614
Keener Sand (pay, 1619-1629')	1614	1637
Total depth		1640