


LATITUDE 39° 27' 30"

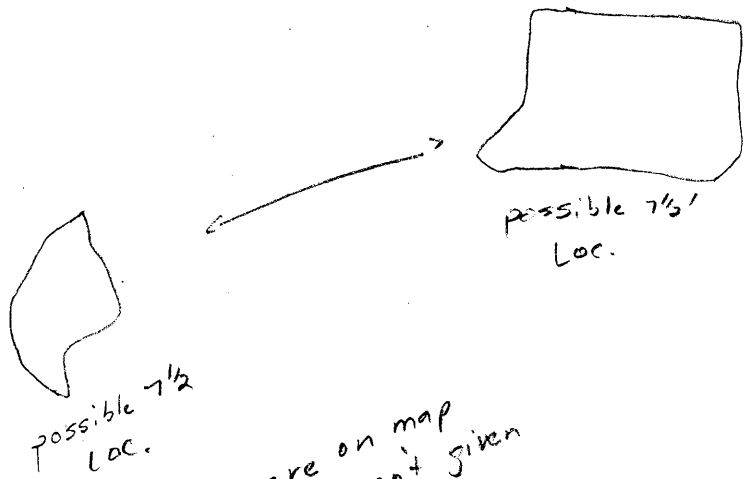

* Both wells are on map
 but numbers aren't given
 on well information

LONGITUDE 86° 45' 00"

7.5 OGIS topo location

7.5' loc _____ 15' loc _____
 (calc.) _____

Company _____

Farm _____

Quad Shirley 7 1/2'

County Tyler

District McElroy

WELL LOCATION MAP

File No. 095-70271
095-70272

McElroy
.....District, Tyler County, W. Va.
Carter Oil Co.
Indian Creek.

W. H. ...
...

	Top.	Bottom.
Cow Run Sand	850	1000
Big Line	1675	1720
Break	1753	1763
Big Injun Sand (gas showing, 1725'; 1st pay, 1770-1775'; 2nd pay, 1782-1792')		1763
Total depth		1856