


LATITUDE 39° 27' 30"

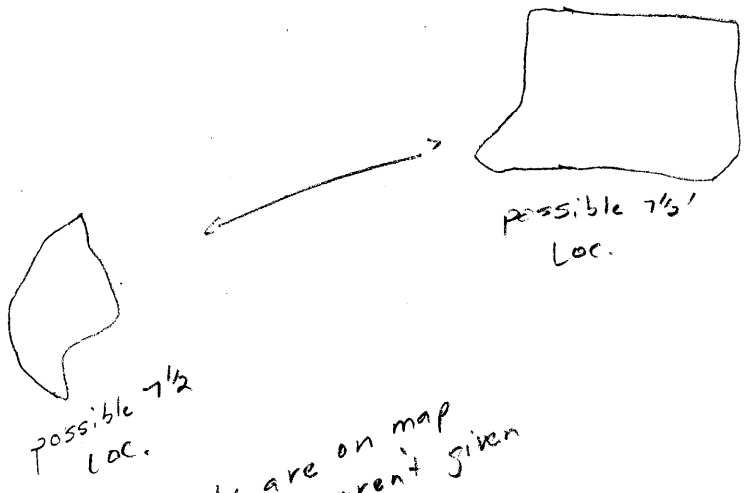

* Both wells are on map
but numbers aren't given
on well information

LONGITUDE 86° 45' 00"

7.5 OGIS topo location

7.5' loc _____ 15' loc _____
 (calc.) _____

Company _____

Farm _____

Quad Shirley 7 1/2'

County Tyler

District McElroy

WELL LOCATION MAP

File No. 095-70271
095-70272

McElroy District, Tyler County, W. Va.
American Oil & Dev. Co.
Elevation, 730'.
Completed in 1900.
On Indian Creek.
Shown on G-C, West Union Quadrangle.

70272

*no water
found*

7

Big Injan Sand
Total depth

Top. Bottom.
1700 - 1774
1800