

LATITUDE

39 40

5208

OGIS
7.5' loc

LONGITUDE

7.5 OGIS topo location

7.5' loc	<u>0.178</u>	15' loc	<u>0.178</u>
	<u>1.45W</u>	(calc.)	<u>1.45W</u>

Company _____

Farm _____

Quad Hundred Maningba NC

County _____

District Church

WELL LOCATION MAP

File No. Wet. 16 048

6-6-048

(048)

STATE OF WEST VIRGINIA
DEPARTMENT OF MINES
OIL AND GAS DIVISION

794

WELL RECORD

Permit No. **WET-16-D**

DRILLING DEEPER

Oil or Gas Well **Gas**
(Kind)

Company **Pittsburgh & West Va Gas Company.**
Address **Clarksburg, West Va.**
Farm **Caroline Hibbs** Acres **130**
Location (waters) **Mann. N/W. 3-2**
Well No. **5395** Elev. **1415'**
District **Church** County **Wetzel**
The surface of tract is owned in fee by **Ross Henderson**
Address **Hundred, W.Va.**
Mineral rights are owned by **Edith M. Hibbs**
R.F.D.#7. Address **Bellevue, Penna.**
Drilling commenced **December 19th, 1939.**
Drilling completed **February 12th, 1940.**
Date shot..... Depth of shot.....
Open Flow **40/10ths** Water in **2"** Inch
..... /10ths Merc. in..... Inch
Volume..... **304,000** Cu. Ft.
Rock Pressure **42** lbs. **3** hrs.
Oil..... bbls., 1st 24 hrs.
Fresh water..... feet..... feet
Salt water..... feet..... feet


Casing and Tubing	Used in Drilling	Left in Well	Packers
Size			
16.....			Kind of Packer.....
13.....			
10.....			Size of.....
8 1/4.....			
6 5/8.....			Depth set.....
5 3/16.....			
3.....			Perf. top.....
2.....			Perf. bottom.....
Liners Used.....			Perf. top.....
			Perf. bottom.....

CASING CEMENTED..... SIZE..... No. Ft..... Date.....
COAL WAS ENCOUNTERED AT..... FEET..... INCHES
..... FEET..... INCHES..... FEET..... INCHES
..... FEET..... INCHES..... FEET..... INCHES

Formation	Color	Hard or Soft	Top	Bottom	Oil, Gas or Water	Depth Found	Remarks
Began drg. deeper at 2504 feet.							
Big Injun	Dark	Hard		2604			
Slate-Shells	"	Soft&Hard	2604	2662			
Lime	"	Hard	2662	2752			
Slate&Shells	"	Soft&Hard	2752	2782			
Lime	White	Hard	2782	2840			
Slate&Shell	Dark	Soft&Hard	2840	2880			
Lime	"	Hard	2880	2915			
Slate&Shell	"	Soft&Hard	2915	2954			
Lime	White	Hard	2954	2964			
Slate&Shell	"	Soft&Hard	2964	3034			
Sand	"	Hard	3034	3050			
Slate&Shell	Dark	Soft&Hard	3050	3070			
Lime	White	Hard	3070	3081			
Slate	"	Soft	3081	3089			
Lime-Shells	"	Soft&Hard	3089	3114			
Fifty Foot Sd.	"	Hard	3114	3137			
Slate	"	Soft	3137	3144			
Thirty Foot	"	Hard	3144	3173			
Pink Reck	Pink	Soft	3173	3178			
Gordon Stray	White	Hard	3178	3197			
Slate	Dark	Soft	3197	3222			
Gordon Sand	"	Hard	3222	3290			
Slate	"	Soft	3290	3324			
Ath.Sand	White	Hard	3324	3363	Gas	3340-45' S.L.3340'	
Slate	Dark	Soft	3363	3384	"	3357-3361' 40/10 W 2"	
Total Depth	-----			3384			

3384
2504

880 - new footage

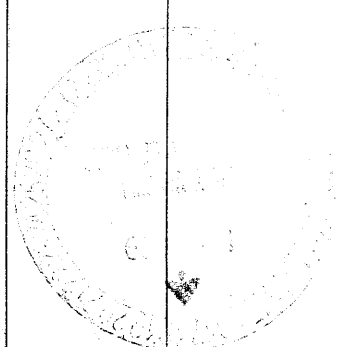

Wet- 16

PITTSBURGH & WEST VA GAS Company

COMPLETION DATA SHEET

CLARKSBURG, WEST VA. Address

NO. 2

Well No. 5395 Caroline Hibbs farm.

FORMATION RECORD

Church Dist., Wetzell Co., W.Va.

Name	Color	Character	Oil, Gas or Water	Top	Bottom	Thickness	Total Depth	Remarks
Soil	Dark	Soft			6	6	6	
Clay	Yellow	"		6	16	10	16	
Stone	White	Hard		16	50	44	50	
Slate	Dark	Soft		50	100	50	100	
Red Rock	Red	"		100	195	95	195	
Lime	White	Hard		195	200	5	200	
Slate	Dark	Soft		200	275	75	275	
Red Rock		"		275	325	50	325	
Slate	Dark	"		325	400	75	400	
Lime	White	Hard		400	450	50	450	
Red Rock		Soft		450	500	50	500	
Slate	Dark	"		500	575	75	575	
Lime	White	Hard		575	600	25	600	
Red Rock		Soft		600	650	50	650	
Slate	Dark	"		650	745	95	745	
Bluff Sand	White	Hard		745	785	40	785	
Slate	Dark	Soft		785	790	5	790	
Coal		"		790	793	3	793	Fairview
Lime	White	Hard		793	800	7	800	
Slate	Dark	Soft		800	850	50	850	
Lime	White	Hard		850	900	50	900	
Slate	"	Soft		900	950	50	950	
Lime	"	Hard		950	1020	70	1020	
Slate	Dark	Soft		1020	1025	5	1025	
Coal		"		1025	1030	5	1030	Mapletown.
Lime	White	Hard		1030	1035	5	1035	
Slate	Dark	Soft		1035	1045	10	1045	
Lime	White	Hard		1045	1115	70	1115	
Slate	Dark	Soft		1115	1130	15	1130	
Coal		"		1130	1138	8	1138	Pittsburgh
Lime	White	Hard		1138	1145	7	1145	
Slate	Dark	Soft		1145	1200	55	1200	
Lime	White	Hard		1200	1310	110	1310	
Red Rock		Soft		1310	1530	220	1530	
L. Dunkard	White	Hard		1530	1580	50	1580	
Slate	Dark	Soft		1580	1635	155	1635	
B. Dunkard	Light	Hard		1635	1730	95	1730	
Slate	Dark	Soft		1730	1800	70	1800	
Gas Sand	White	Hard		1800	1840	40	1840	
Slate	Dark	Soft		1840	1935	95	1935	
1st. Salt	Light	Hard		1935	1995	60	1995	
Slate	Dark	Soft		1995	2050	55	2050	
2nd. Salt	White	Hard		2050	2150	100	2150	
Slate	Dark	Soft		2150	2235	80	2235	
Red Rock		"		2235	2250	15	2250	
Maxon	White	Hard	Gas 2275	2250	2305	55	2305	See sheet #2

PITTSBURGH & WEST VA GAS Company

COMPLETION DATA SHEET

CLARKSBURG, WEST VA. Address

NO. 2

Well No. 5395 Caroline Hibbs farm.

FORMATION RECORD

Church Dist., Wetzell Co. W.Va.

Name	Color	Character	Oil, Gas or Water	Top	Bottom	Thickness	Total Depth	Remarks
Slate	Dark	Soft		2305	2310	5	2310	
Big Lime	White	Hard		2310	2360	50	2360	
Big Injun	"	"	Gas 2390	2360				
			" 2412					
			" 2456					
			" 2464					
T O T A L D E P T H -----							2504	

Well was ~~not~~ shot at **Not shot.** feet; well was shot at _____ feet.

Salt _____ salt
 Fresh water at _____ feet; fresh water at _____ feet.

Well was producing hole.
~~dry~~

PITTSBURGH & WEST VA GAS COMPANY.

May 20th, 1930.

Approved _____

By, J. F. Money Superintendent.
 Owner

Date

NOTE: All bottom formations must be noted as indicated above and all key-rocks and oil and gas sands must be recorded under their proper geological names in the district as well as any local names commonly used in the district for such strata.