

WW-7
8-30-06



West Virginia Department of Environmental Protection
Office of Oil and Gas
WELL LOCATION FORM: GPS

API: 47-103-00026 WELL NO.: 4528

FARM NAME: HARRY M. ANTILL

RESPONSIBLE PARTY NAME: CONSOLIDATION COAL COMPANY

COUNTY: WETZEL DISTRICT: CHURCH

QUADRANGLE: HUNDRED WV, PA 7.5'

SURFACE OWNER: FLOYD E. & FRANCIS POSTLETHWAIT

ROYALTY OWNER: _____

UTM GPS NORTHING: 4,388,809 m

UTM GPS EASTING: 550,471 m GPS ELEVATION: 380 m (1247')

The Responsible Party named above has chosen to submit GPS coordinates in lieu of preparing a new well location plat for a plugging permit or assigned API number on the above well. The Office of Oil and Gas will not accept GPS coordinates that do not meet the following requirements:

1. Datum: NAD 1983, Zone: 17 North, Coordinate Units: meters, Altitude: height above mean sea level (MSL) – meters.
2. Accuracy to Datum – 3.05 meters
3. Data Collection Method:

Survey grade GPS _____: Post Processed Differential _____

Real-Time Differential _____

Mapping Grade GPS X: Post Processed Differential X

Real-Time Differential _____

4. **Letter size copy of the topography map showing the well location.**

I the undersigned, hereby certify this data is correct to the best of my knowledge and belief and shows all the information required by law and the regulations issued and prescribed by the Office of Oil and Gas.

Signature

Professional Surveyor
Title


JUNE 14, 2019
Date

RECEIVED
Office of Oil and Gas

AUG 16 2019

WV Department of
Environmental Protection

47 10300026P

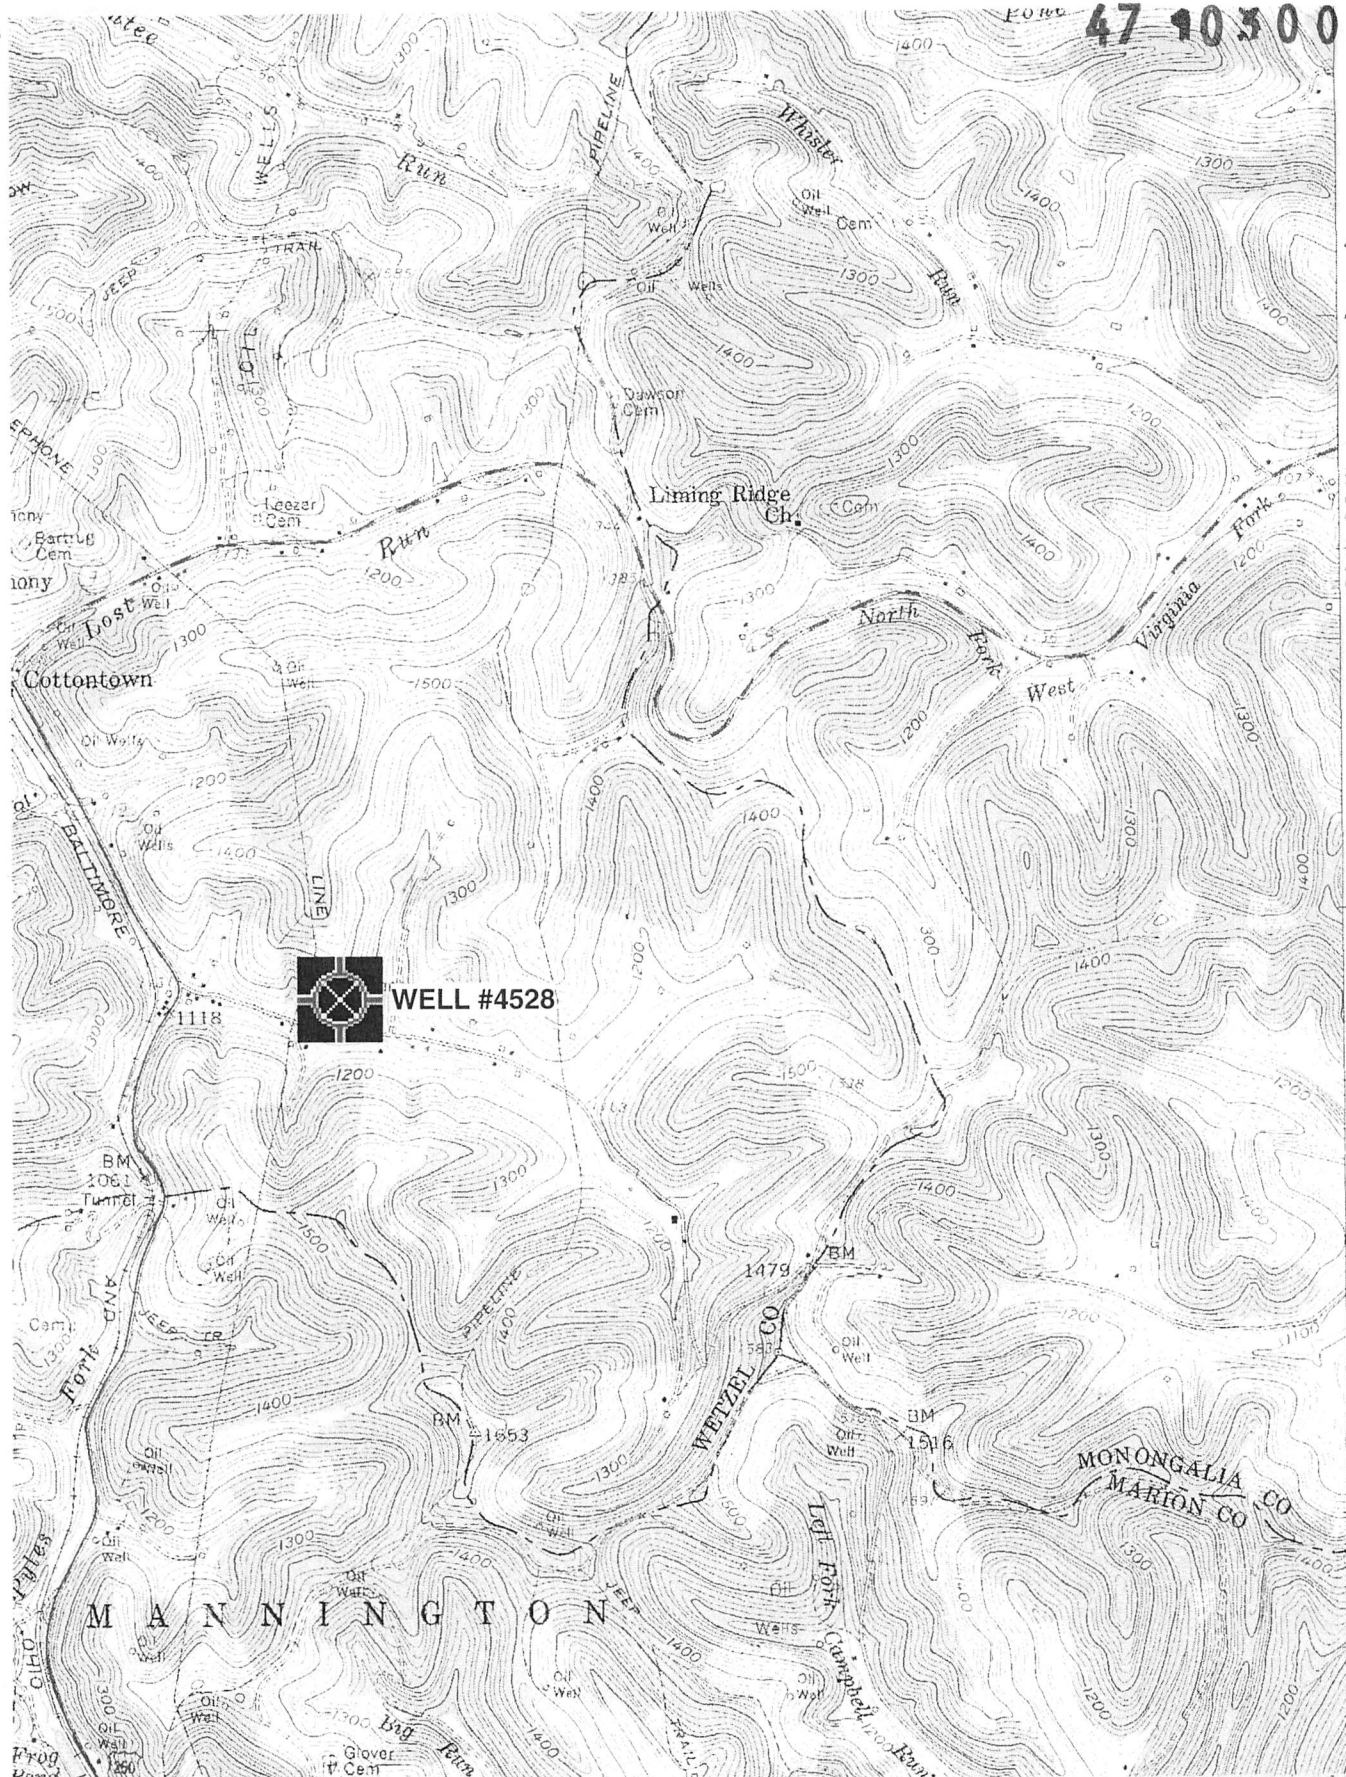

WELL #4528

4301
40'

4389

43882066° N

120 000 FEET

(PA) RECEIVED

Office of Oil and Gas

AUG 16 2019

WV Department of Environmental Protection

39°37'30"
80°22'30"

1/16 MI
1/32 MI

1 MILE

7000 FEET
METER

INTERIOR GEOLOGICAL SURVEY, RESTON, VIRGINIA - 1977
52 53300mE

ROAD CLASSIFICATION

- Heavy duty
- Medium duty
- Light duty
- Unimproved dirt
- U. S. Route
- State Route

(MANNINGTON)
SE CORNER

'Hundred; WV, PA' Scale: 1" = 0.379Mi 610Mt 2,000Ft, 1 Mi = 2.640" , 1 cm = 240Mt

Well# 4528

HUNDRED WV, PA 7.5' Quad

Scale: 1" = 500'

Oil Well



1400

LINE

1300

Old Harmony Cem

1118

Well# 4528

1200


Oil Well

1300

1500

Oil

Access Road

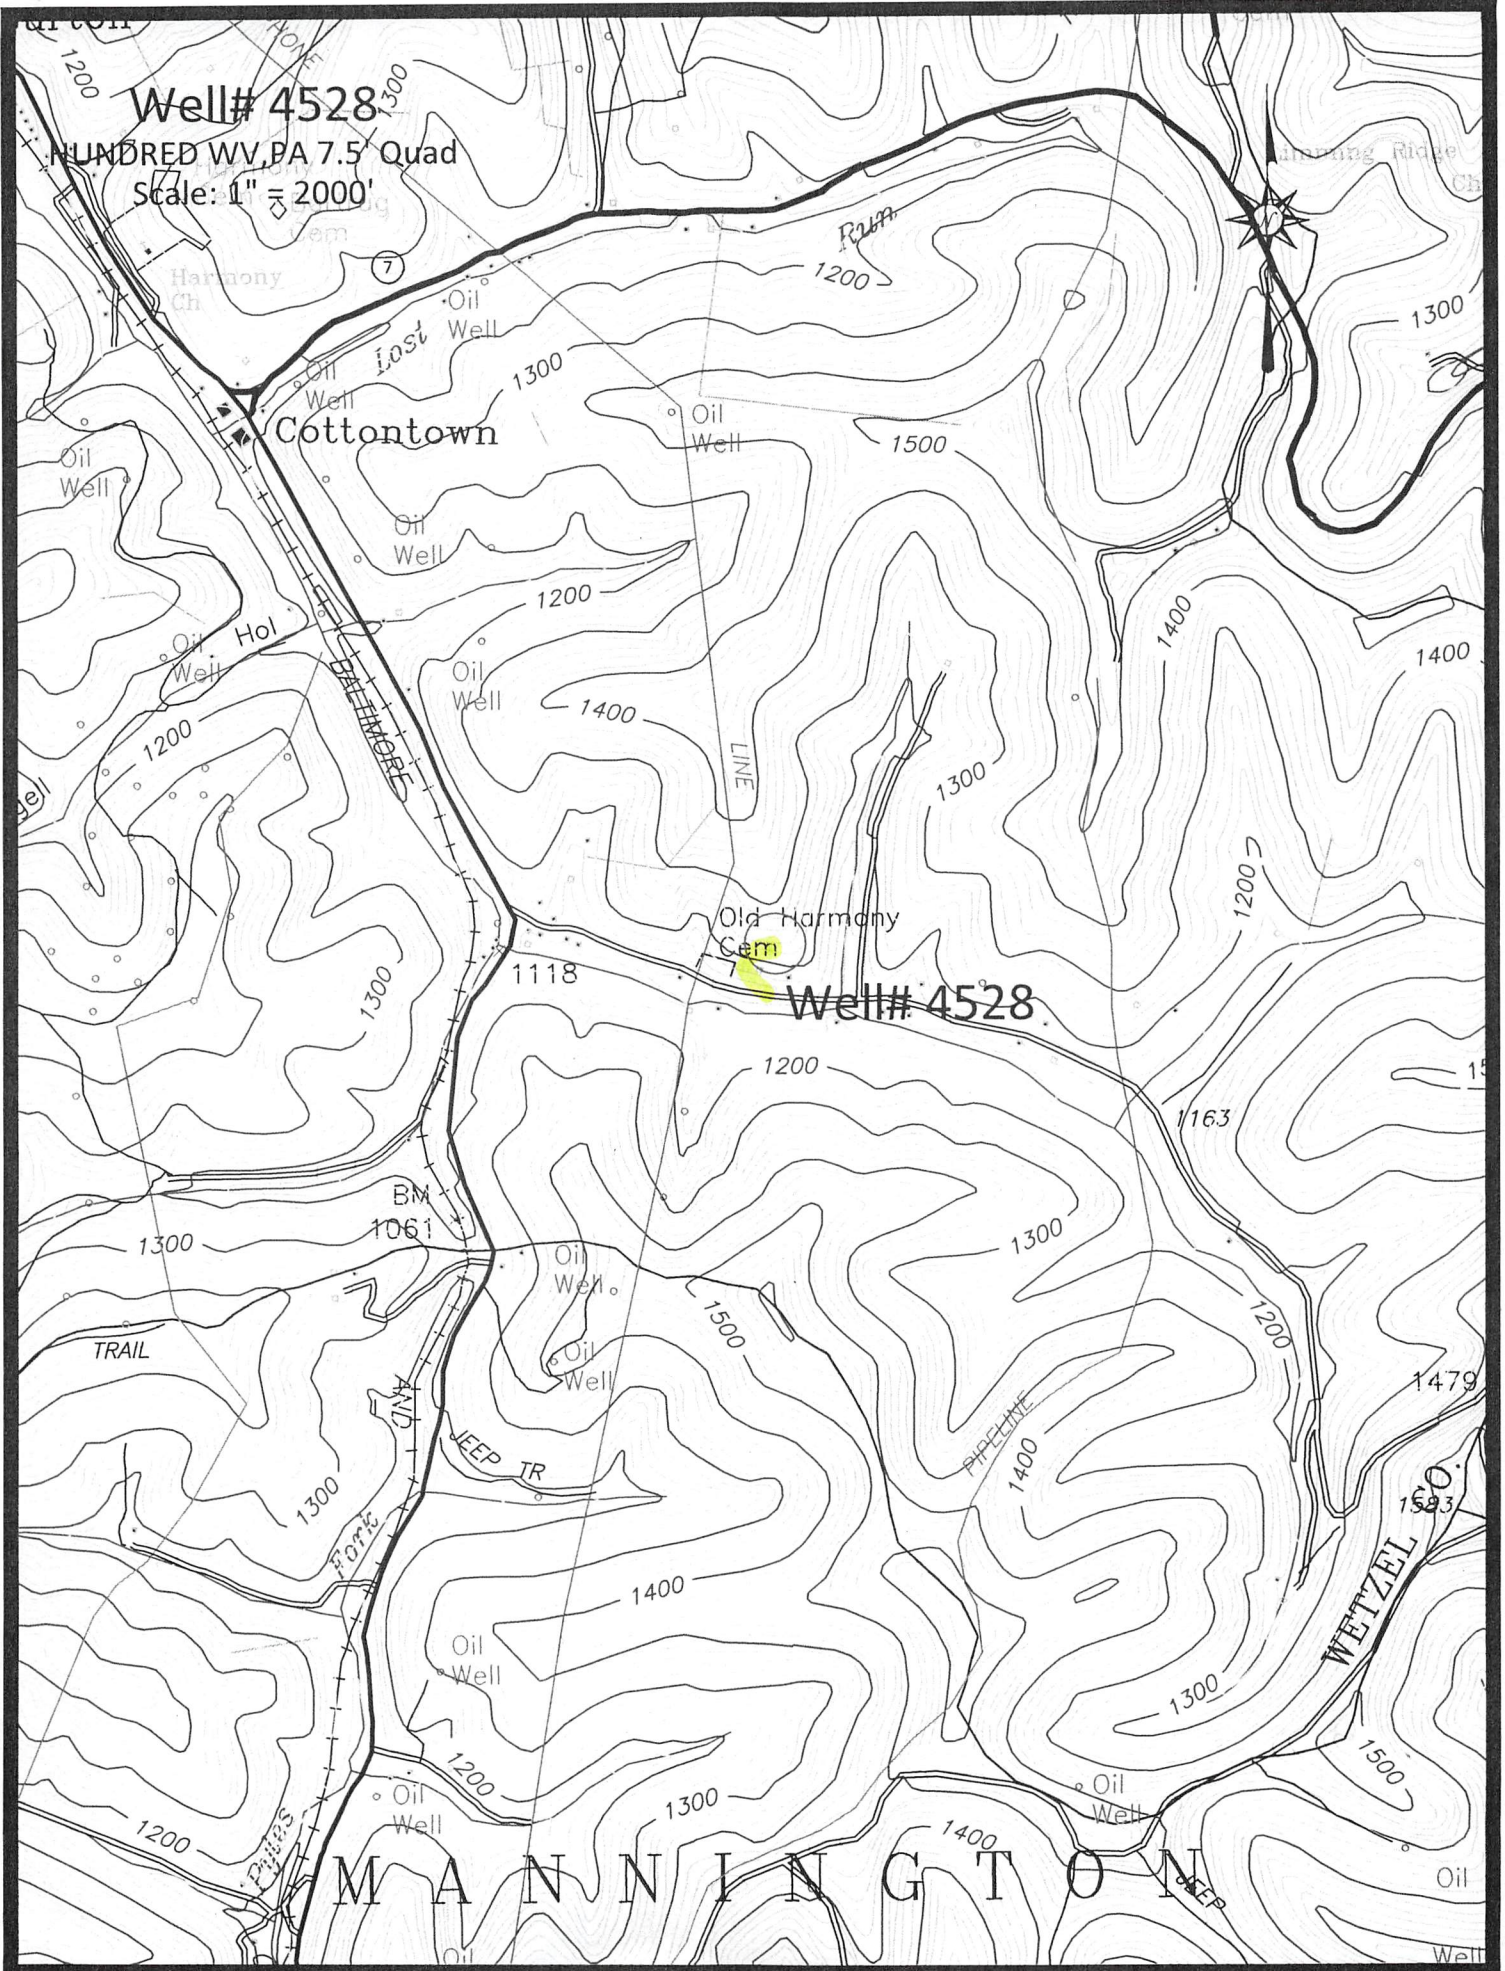

Well# 4528

HUNDRED WV, PA 7.5' Quad

Scale: 1" = 2000'

Cottontown

Well# 4528

Old Harmony Cem

MANNINGTON

Area R-1